

Name

Service No.

Address

45 Blake Road
Lot "B"

Location

Kind of Pipe

Size

Size of Main

Repair—Renewal—New Service


Location

Date	Material	Amount		Total	Date		Amount
Oct. '67 23'	6" Transite pipe @	7.00		161. 00			

DATE _____

TOWN OF LEXINGTON — BOARD OF PUBLIC WORKS
SEWER DIVISION

Sketch of Service Here **45**

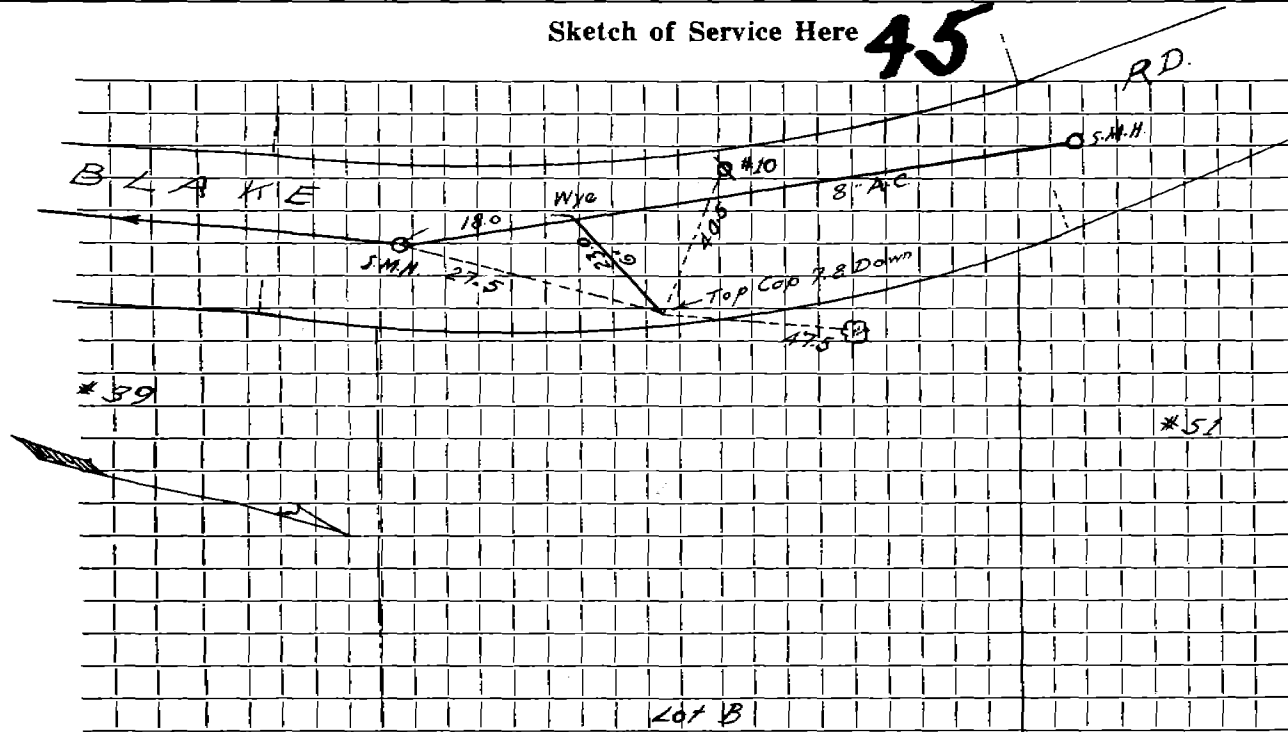

Connection made in Street. Work completed

Remarks:

.....

.....