

Name J. Calvin Bartlett

Service No. 10

Address 51 Blake Road

Location *Comm. 4/29/57*

Kind of Pipe

Size

Size of Main

~~Repair~~ ~~Renewal~~ — New Service

Location

Date	Material	Amount	Total	Date	Amount
3-18-57	Labor	127.44		2-1-57	<i>Deposit</i>
	10% C.H.	12.74	140.18	5-16-57	<i>Paid</i>
	60' 6" Transite Pipe @.7020		42.12		<i># 300.00</i>
	1 Cesspool Cover		8.00		<i># 19.80</i>
	500 Brick @38.00 M		19.00		<i># 319.80</i>
	5 bags Cement @ 1.35		6.75		
	1T. Sand		1.00	'56'	
	3 hrs. Town Shovel @ 6.50		19.50	26.6'	<i>6" V.C. Sewer Pipe</i>
	5 hrs. Trucking @.75		3.75		
	Previous Charge		79.50		
			319.80		<i>Bill sent 5/2/57</i>
	Labor				

TOWN OF LEXINGTON—DEPT. OF PUBLIC WORKS
SEWER DIVISION

DATE


NO.

The undersigned applies for the construction of a particular sewer connecting No.
Street and hereby agrees to comply with the Rules and Regulations governing the construction and use of Particular
Sewers, as now or at any future time established by the Board of Selectmen.

Am't of estimate \$.....

Am't Paid \$.....

..... Owner

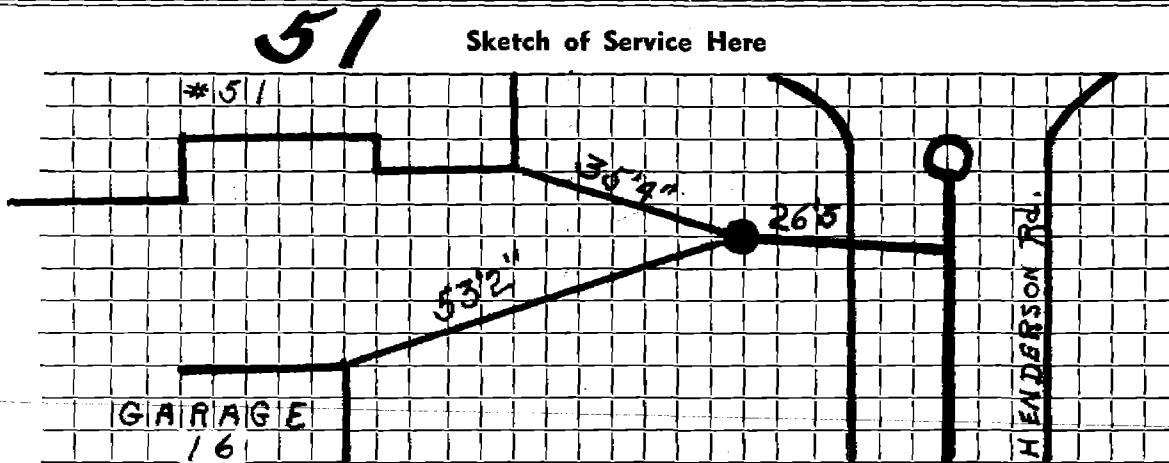

Connection made in Street.

Work completed 19..

Remarks: