

Name Brooks F. Jakeman

Service No. 6

Address 57 Blake Road

Location

Comm. 4/29/57

Kind of Pipe

Size

Size of Main

~~Repair~~ ~~Renewal~~ — New Service

Location

Date	Material	Amount	Total	Date	Amount
2/26/57	Labor	67 42		2-19-57	Deposit \$ 300 00
2/27/57	"	102 87		5-7-57	Paid \$ 68 44
2/28/57	"	57 91			\$ 368 44
		228 20		'56'	
	10% overhead	22 82	251 02	18.6'	6" V.C. Sewer Pipe
	85' - 6" Transite Pipe @ .7020		59 67		
	3 hrs. Trucking @ .75		2 25		
			312 94		
	18 1/2' 6" Sewer Pipe @ 3.00				
	installed by contractor		55 50		
			368 44		
	Labor				
					Bill sent 5/2/57

TOWN OF LEXINGTON—DEPT. OF PUBLIC WORKS
SEWER DIVISION

DATE

NO.


The undersigned applies for the construction of a particular sewer connecting No.
Street and hereby agrees to comply with the Rules and Regulations governing the construction and use of Particular
Sewers, as now or at any future time established by the Board of Selectmen.

Am't of estimate \$.....

Am't Paid \$.....

..... Owner

Sketch of Service Here **57**

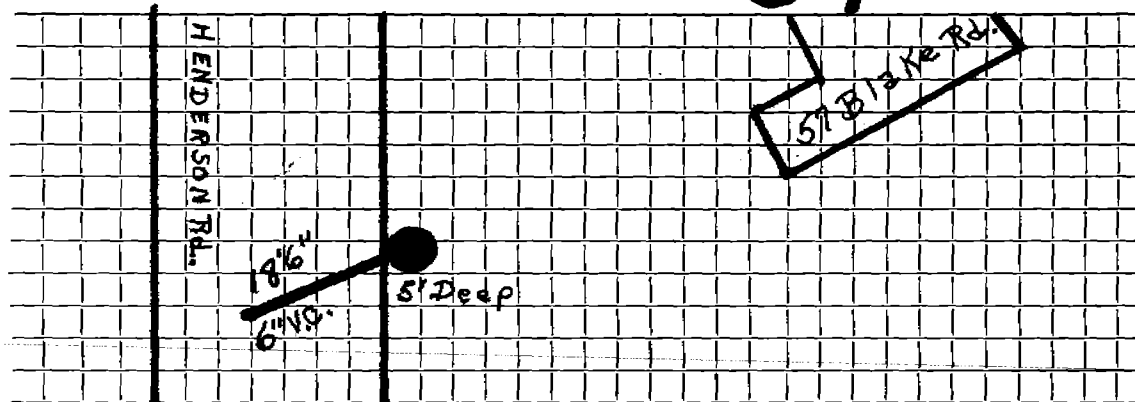

Connection made in Street.

Work completed 19..

Remarks: