

Name Margaret Dailey

Service No. 105

Address # 58 Blake Road

Location

Kind of Pipe

Size

Size of Main

Repair—Renewal—New Service

Russell Sibley Contracting Company #2917

Location

AUG 18 1976

Date	Material	Amount	Total	Date	Amount
------	----------	--------	-------	------	--------

Oct. '67	22' 6" Transite pipe @	7.00	154.00	10-9-5	Deposit	154 00
----------	------------------------	------	--------	--------	---------	--------


11/6/75	30' 6" Transite Pipe					
---------	----------------------	--	--	--	--	--

	10' 4" Cast Iron Pipe					
--	-----------------------	--	--	--	--	--

DATE _____

TOWN OF LEXINGTON — BOARD OF PUBLIC WORKS
SEWER DIVISION

Sketch of Service Here **58**

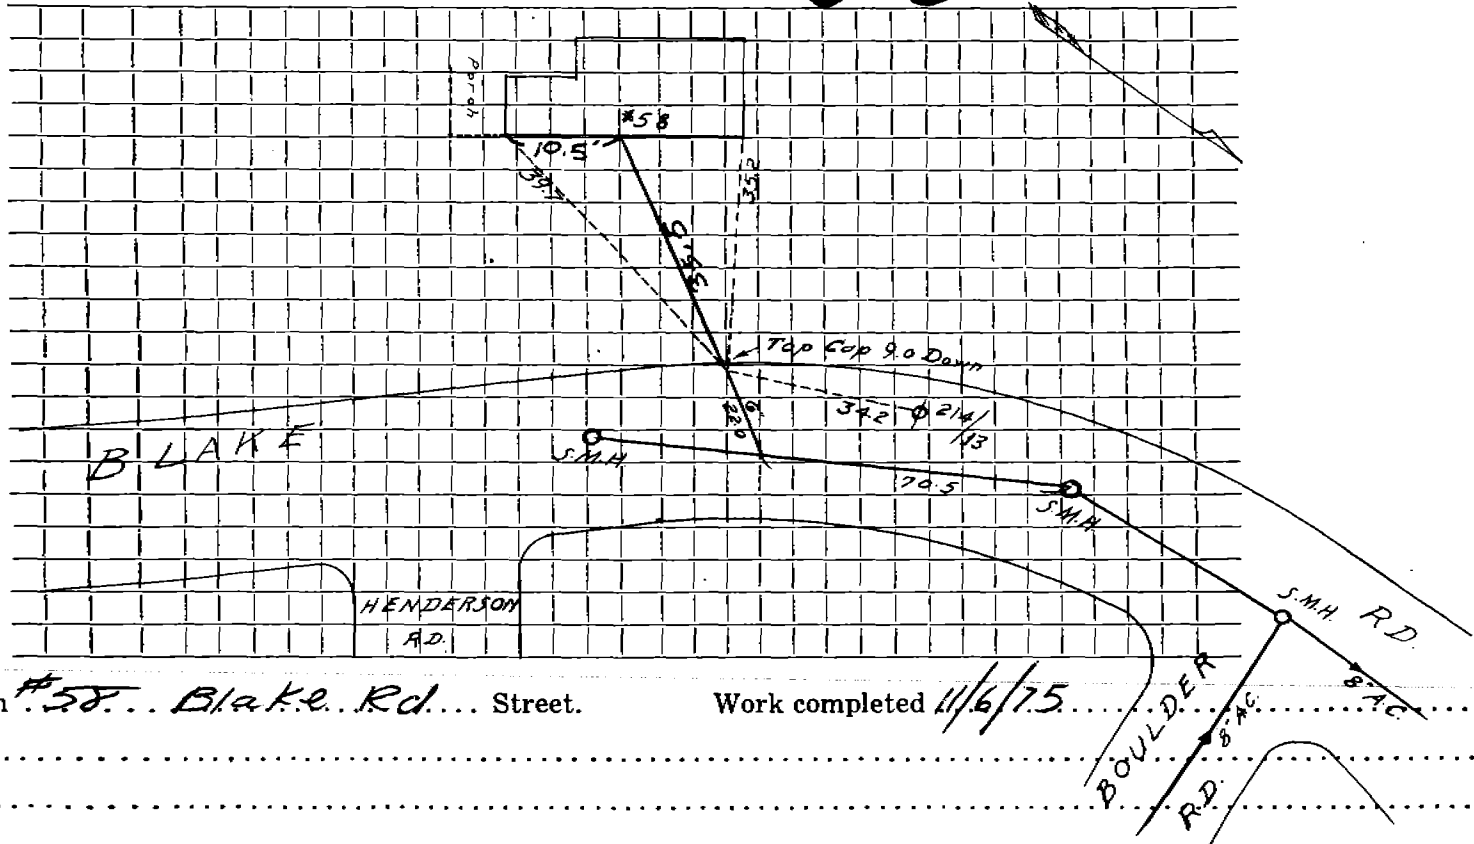

Connection made in #58... Blake Rd.... Street. Work completed 11/6/75.....

Remarks: