

Name

Service No.

Address 60 Blake Road

Location Lots 21 22 P+23

Kind of Pipe

Size

Size of Main

Repair—Renewal—New Service

Location

Date

Material

Amount

Total

Date

Amount

1967

11' 6" Transite Pipe @ 7.00

77 00

11 @ 7


DATE

TOWN OF LEXINGTON — BOARD OF PUBLIC WORKS

SEWER DIVISION

Sketch of Service Here

60

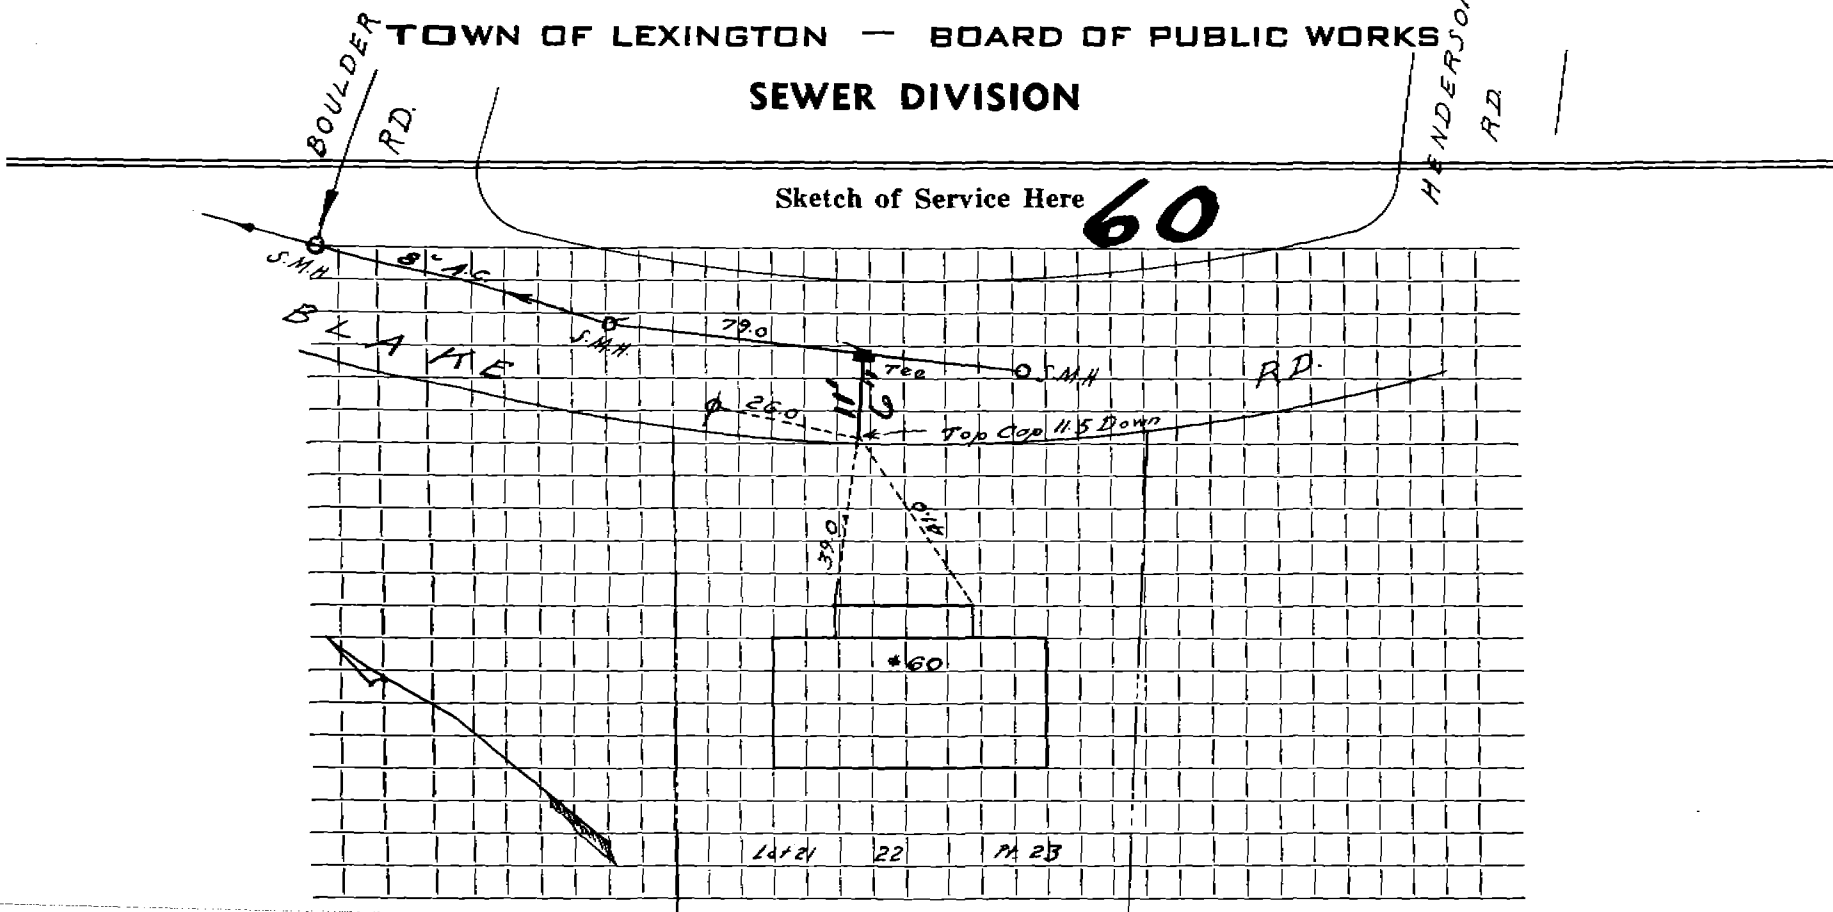

Connection made in Street. Work completed

Remarks:
.....
.....