

Name *Basil G. Dandison*

Service No. 109

Address *65 Blake Road*

Lexington, MA 02173

Location

Kind of Pipe

Size

Size of Main

~~Repair/Alteration~~ **New Service**

Suburbanite Cesspool-Permit #3192--W.O. #5920

Location

FEB 13 1978


Date	Material	Amount	Total	Date	Amount
12-8-77	Labor	133 71		<i>11-22-77</i>	<i>Deposit</i>
	10% O.H.	13 37	147 08	<i>2-10-78</i>	<i>Paid</i>
	30'-4" Cast iron pipe @ 16.13		48 39		<i>250 00</i>
	1 - 4" x 1/8" Castiron bend		2 25		<i>3 52</i>
	4 - 4" Cast iron couplings @ 1.70		6 80	12-8-77	<i>OUTSIDE</i>
	6 Yds. Gravel @ 4.50		27 00		<i>Hot Top 4 x 4</i>
	3 Hrs. Trucking @ 3.00		9 00		<i>10 68</i>
	2 Hrs. Backhoe @ 6.50		13 00		
			253 52		
12-5-77	44' 4" CI				

DATE

TOWN OF LEXINGTON — BOARD OF PUBLIC WORKS
SEWER DIVISION

Sketch of Service Here

65

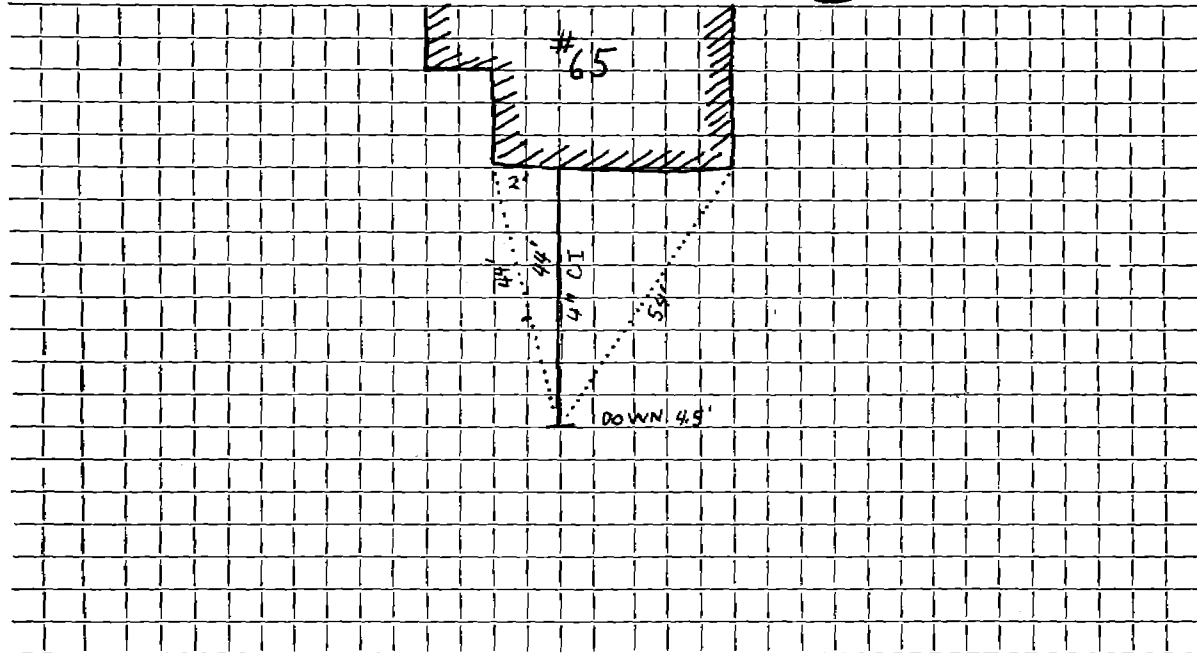

Connection made in Street. Work completed

Remarks:
.....
.....