




DATE \_\_\_\_\_

TOWN OF LEXINGTON — BOARD OF PUBLIC WORKS  
SEWER DIVISION

Sketch of Service Here

**70**

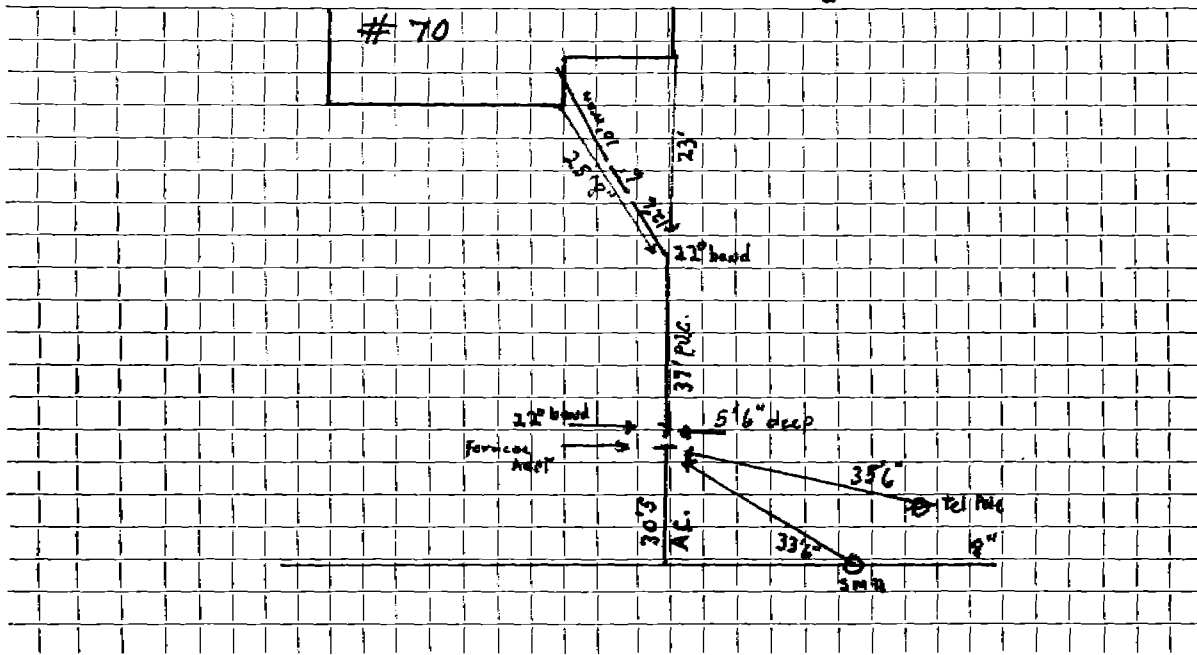

Connection made in Blake Rd permit - 3627 Street. Work completed 12-13-80

Remarks: .....

.....

.....