

Name Robert Morrison

Service No. 37

Address 73 Blake Rd

Location Comm 8-4-58

Kind of Pipe

Size

Size of Main

~~REPAIR EXIST~~ New Service

Location

Date	Material	Amount	Total	Date	Amount
	16' 6" Sewer Pipe @ 3.00 Per ft.			4-2-58	125.00
	Installed by Cont. 1956		48.00	7-8-58	16.11
	Billed when connected				141.11
4-24-58	Labor	45.06			
	10% overhead	4.51	49.57		
	30' 6" Transite pipe @.70		21.00		
	1 11 1/4° Transite Bend		5.20		
	1 11 1/4° Elbow		2.24		
	2 hrs. Town Shovel @ 6.50		13.00		
	2 hrs. Trucking @.75		1.50		
			<u>141.11</u>		
	Labor				

TOWN OF LEXINGTON—DEPT. OF PUBLIC WORKS  
**SEWER DIVISION**

DATE.....

NO. ....

The undersigned applies for the construction of a particular sewer connecting No.....  
Street and hereby agrees to comply with the Rules and Regulations governing the construction and use of Particular  
Sewers, as now or at any future time established by the Board of Selectmen.


Am't of estimate \$.....

Am't Paid \$.....

..... Owner

Sketch of Service Here

**73**

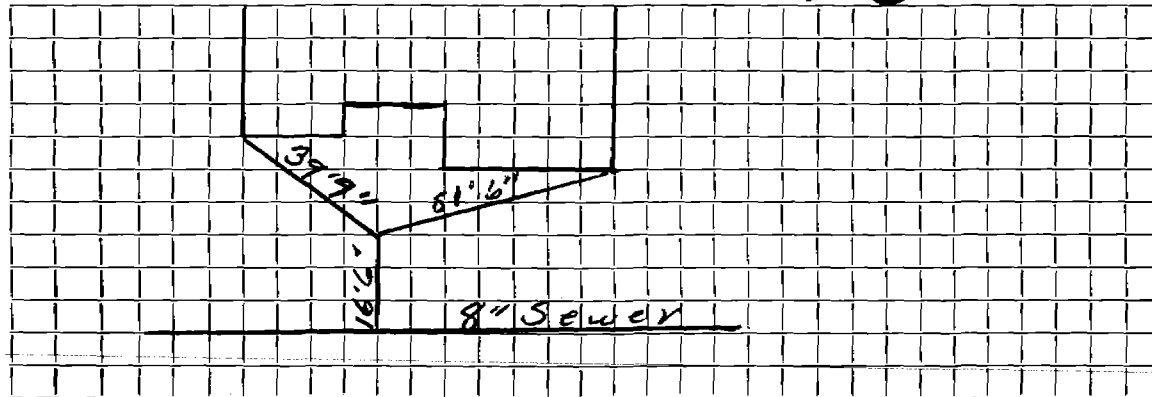

Connection made in ..... Street.

Work completed.....19..

Remarks: