
DAT	F			

TOWN OF LEXINGTON - BOARD OF PUBLIC WORKS SEWER DIVISION

Sketch of Service Here

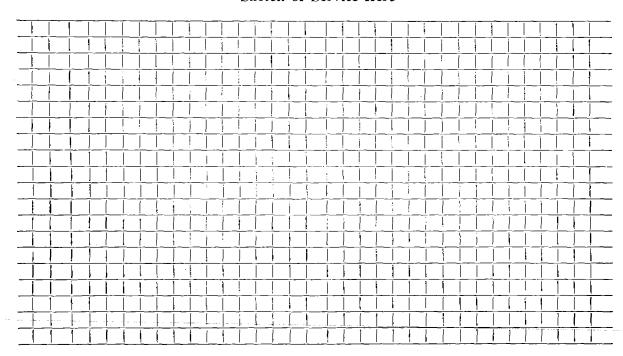

Connection made in Street.	Work completed
Remarks:	