

Name Marshall Dean

Service No. 48

Address 85 Blake Road

Lexington

Location

Kind of Pipe

Size

Size of Main

~~XXXXXX~~ New Service

COM. 4-27-53

Location

Date	Material	Amount	Total	Date	Amount
4/1/53	Labor	48 60		3-25-53	150 -
	10% overhead	4 86	53 46	4-27-53	(41 39)
	43' -5" transite pipe @ .55		23 65		108 21
	6 hrs. town shovel @ 5.00		30 00		
	2 hrs. trucking @ .75		1 50		
			<u>108 61</u>		
	Labor				

**TOWN OF LEXINGTON—DEPT. OF PUBLIC WORKS**  
**SEWER DIVISION**

DATE.....

NO. ....

The undersigned applies for the construction of a particular sewer connecting No.....  
Street and hereby agrees to comply with the Rules and Regulations governing the construction and use of Particular  
Sewers, as now or at any future time established by the Board of Selectmen.


Am't of estimate \$.....

Am't Paid \$.....

..... Owner

---

**Sketch of Service Here**

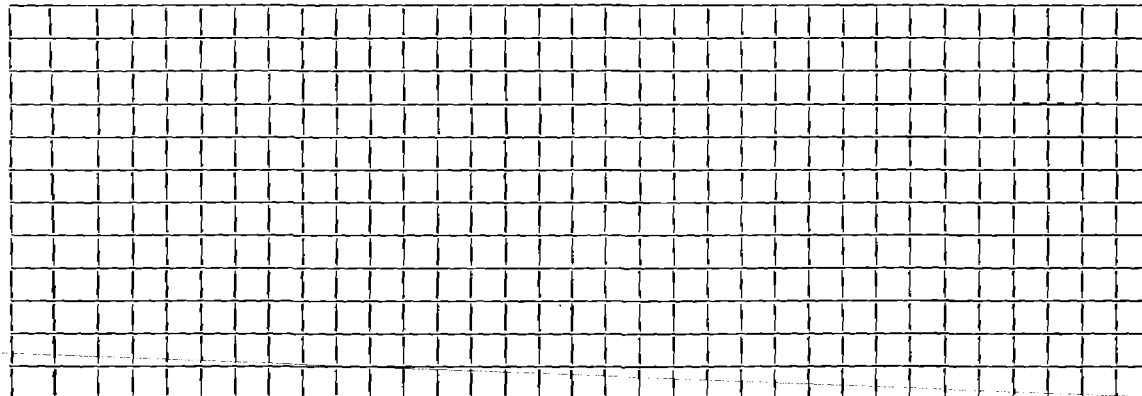

Connection made in ..... Street.

Work completed.....19..

Remarks: