


DATE _____

TOWN OF LEXINGTON — BOARD OF PUBLIC WORKS
SEWER DIVISION

Sketch of Service Here

91

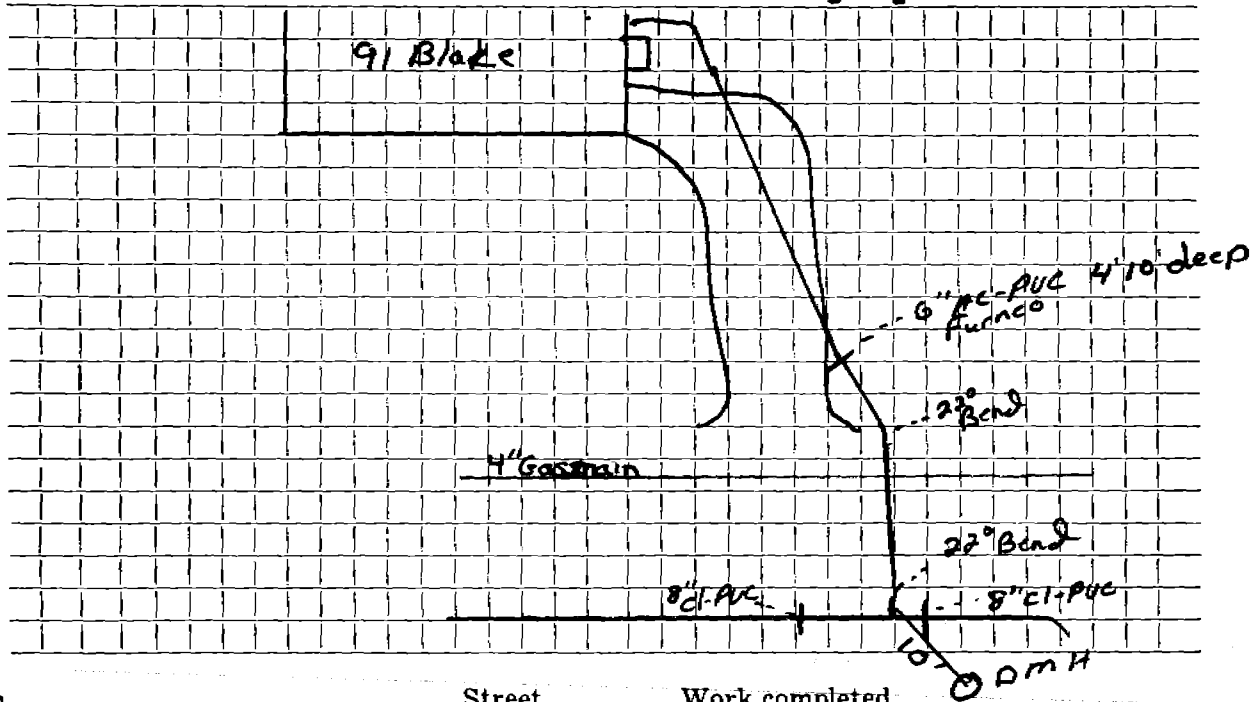

Connection made in Street. Work completed 8-27-92...

Remarks:
.....
.....