

Name

Service No.

Address 95 Blake Road

Location

Kind of Pipe

Size

Size of Main

Repair—Renewal—New Service

Location

Date	Material	Amount	Total	Date	Amount
------	----------	--------	-------	------	--------

	17' 6" V.C. Pipe @ 3.00		51 00		
--	-------------------------	--	-------	--	--

Installed by contractor  
Owner to be billed when connected

17'  
Labor

# TOWN OF LEXINGTON—DEPT. OF PUBLIC WORKS

## SEWER DIVISION

DATE.....


NO. ....

The undersigned applies for the construction of a particular sewer connecting No..... Street and hereby agrees to comply with the Rules and Regulations governing the construction and use of Particular Sewers, as now or at any future time established by the Board of Selectmen.

Am't of estimate \$.....

Am't Paid \$.....

..... Owner

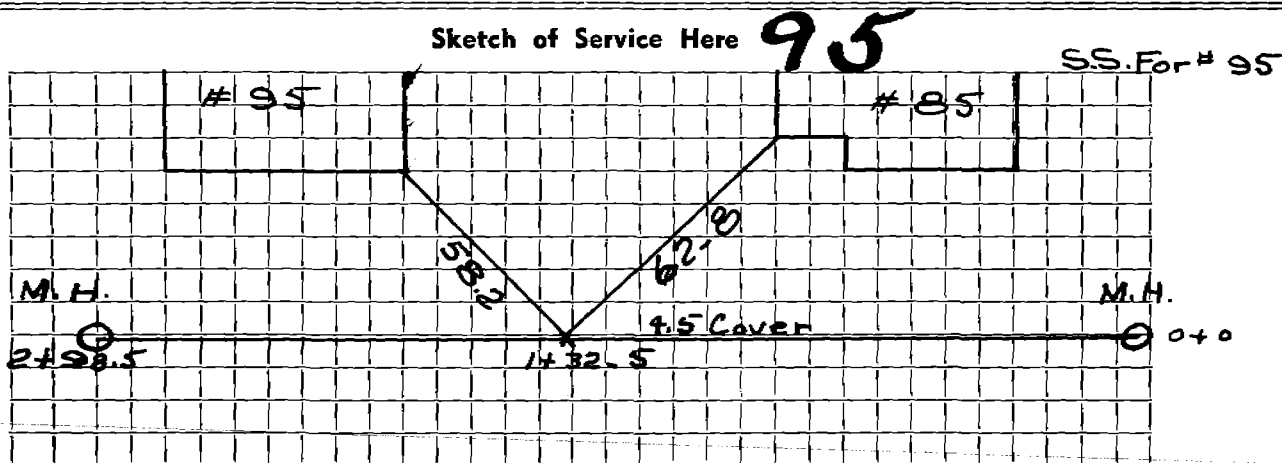

Connection made in ..... Street.

Work completed.....19..

Remarks: