

Name

Service No.

Address *Vacant Lot (M-78, L-291) (North of #127 Blake St.)*

*Blake Road*

Location

Kind of Pipe *PVC wye*

Size *6"*

Size of Main *8"*

Repair—Renewal—New Service

Location

Date

Material

Amount

Total

Date

Amount


*MAY 83*

*No Charge*

DATE \_\_\_\_\_

TOWN OF LEXINGTON — BOARD OF PUBLIC WORKS  
SEWER DIVISION

Sketch of Service Here

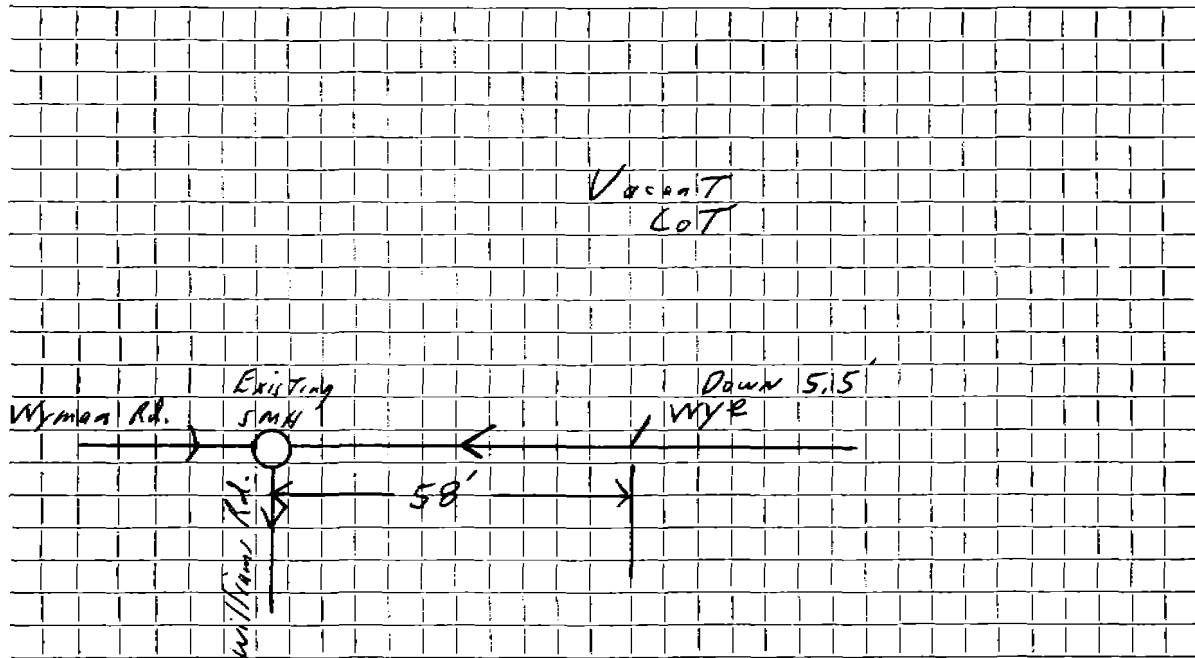

Connection made in Blake Rd Street. Work completed .....

Remarks: Unpaved street