

Name

Service No.

Address 3 Blinn Road

Location

Kind of Pipe

Size

Size of Main

~~Repair-Renewal~~ New Service Pond Realty

Location

Date

Material

Amount

Total

Date


Amount

1964 48 6" Transite pipe

DATE _____

TOWN OF LEXINGTON — BOARD OF PUBLIC WORKS
SEWER DIVISION

Sketch of Service Here **3**

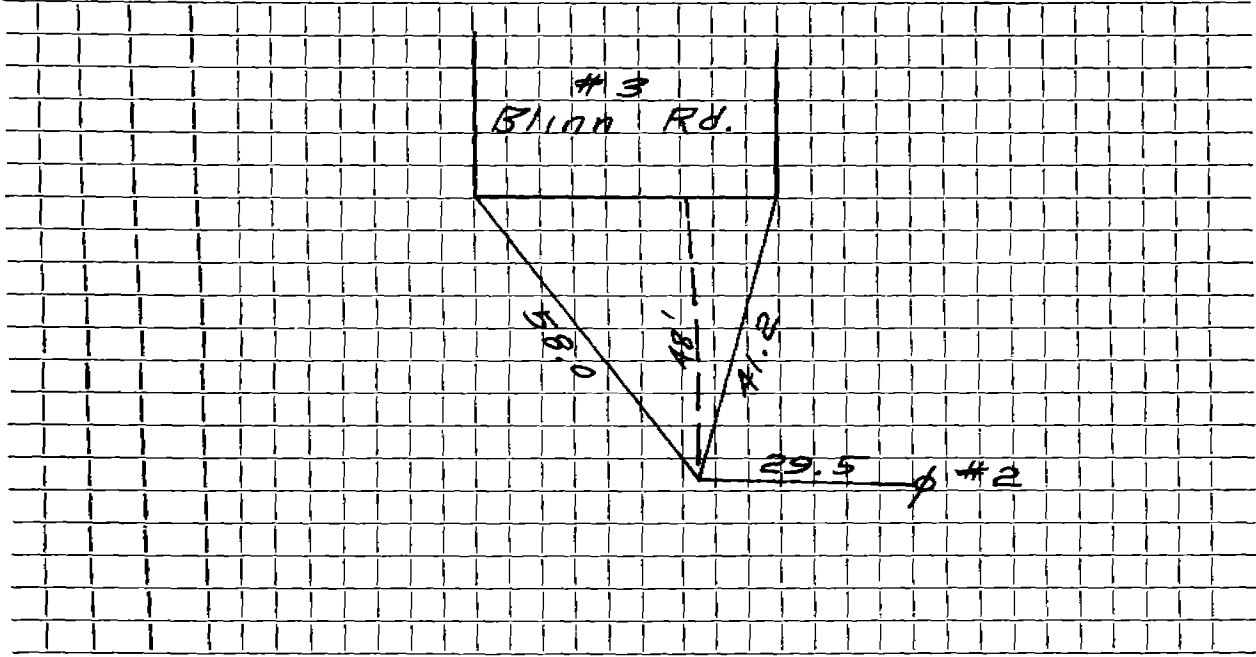

Connection made in Street. Work completed

Remarks:
.....
.....