

Name

Service No.

Address 4 Blinn Road

Location

Kind of Pipe

Size

Size of Main

~~REPAIR/RENEWAL~~ - New Service Pond Realty

Location

Date

Material

Amount

Total

Date

Amount

1963

45' 6" Transite pipe

9-1-05

Respond + Measure
Roots In Service


5m.

DATE _____

TOWN OF LEXINGTON — BOARD OF PUBLIC WORKS
SEWER DIVISION

Sketch of Service Here

4

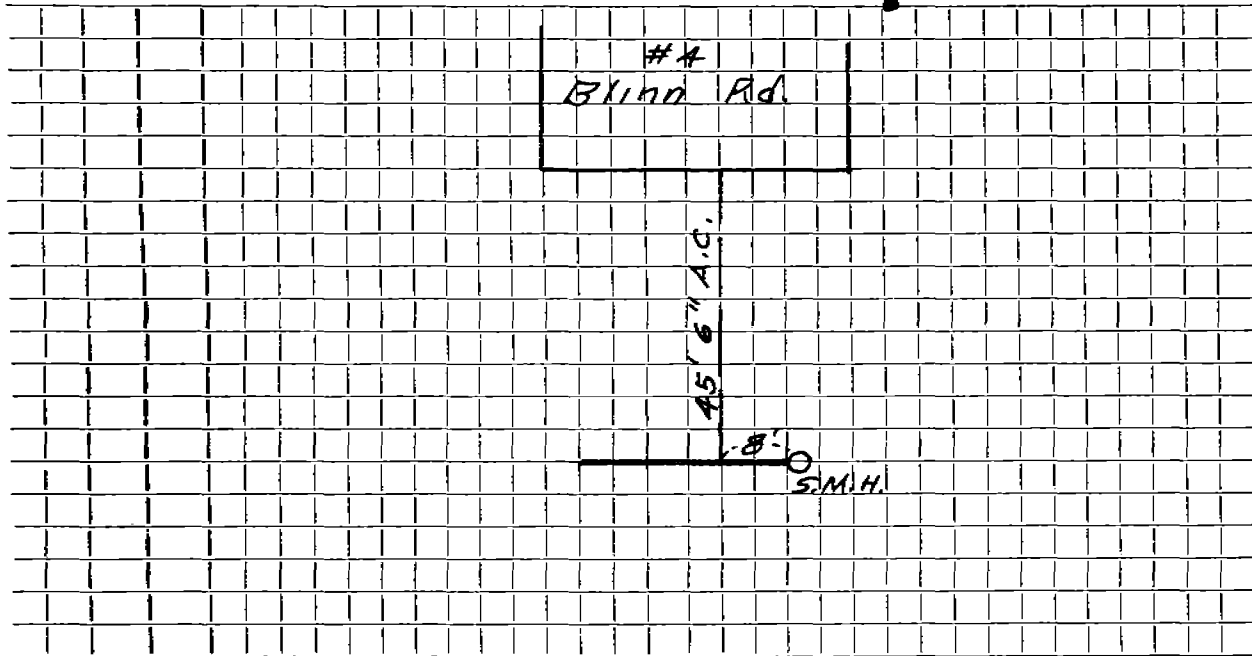

Connection made in Street. Work completed

Remarks: C.O. In Garage