

Name

Stankard Excavating

Service No.

Address

6 Blinn Rd

Location

Kind of Pipe

SDR 35

Size

6"

Size of Main

Repair

~~Renewal~~

New Service

Location

Date

Material

Amount

Total

Date

Amount

3/9/2020

6" SDR 35
PVC pipe

6" - 45° bend
with tee wye
to create
drop.

6" - 45° bend


6" cleanout
at the drop

4" cleanout

DATE 3/9/2020

TOWN OF LEXINGTON — BOARD OF PUBLIC WORKS
SEWER DIVISION

Sketch of Service Here

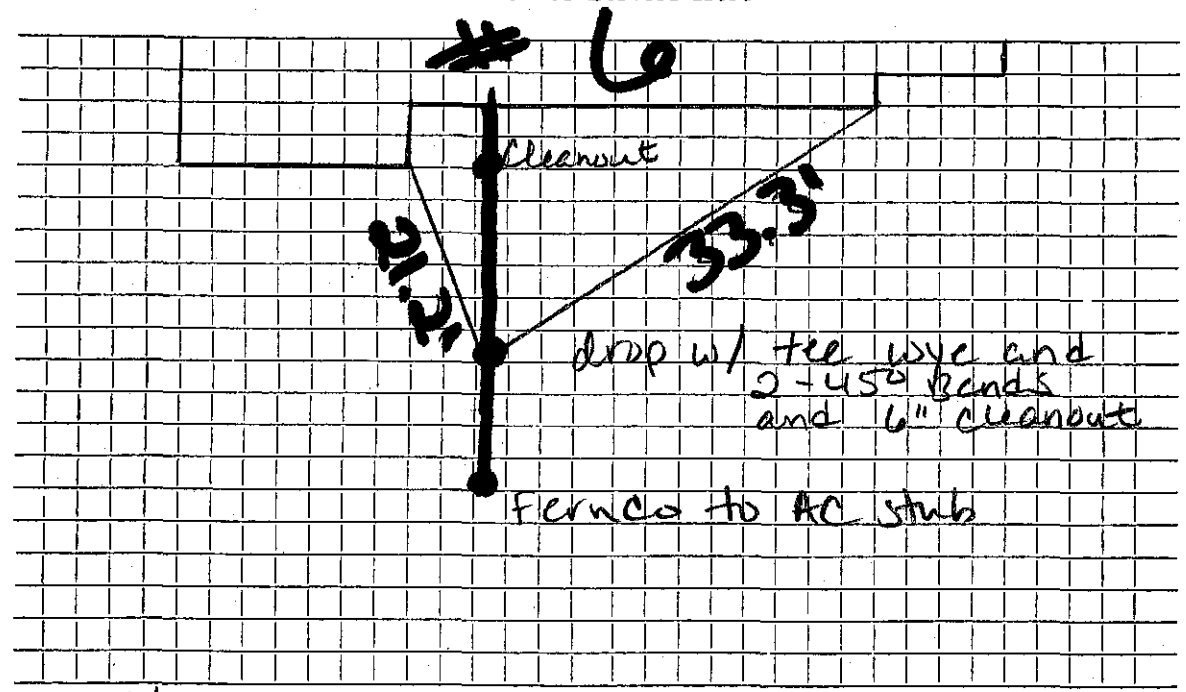

drop w/ tee wye and
2 - 45° bends
and 6" cleanout

ferried to AC stub

Connection made in Blinn Rd Street. Work completed

Remarks:
.....
.....