

Name

Service No.

Address 8 Blinn Road

Location

Kind of Pipe

Size

Size of Main

~~Renewal~~ ~~Renewal~~ New Service Pond Realty

Location

Date

Material

Amount

Total

Date

Amount


1963 86' 6" Transite pipe

DATE _____

TOWN OF LEXINGTON — BOARD OF PUBLIC WORKS
SEWER DIVISION

Sketch of Service Here

8

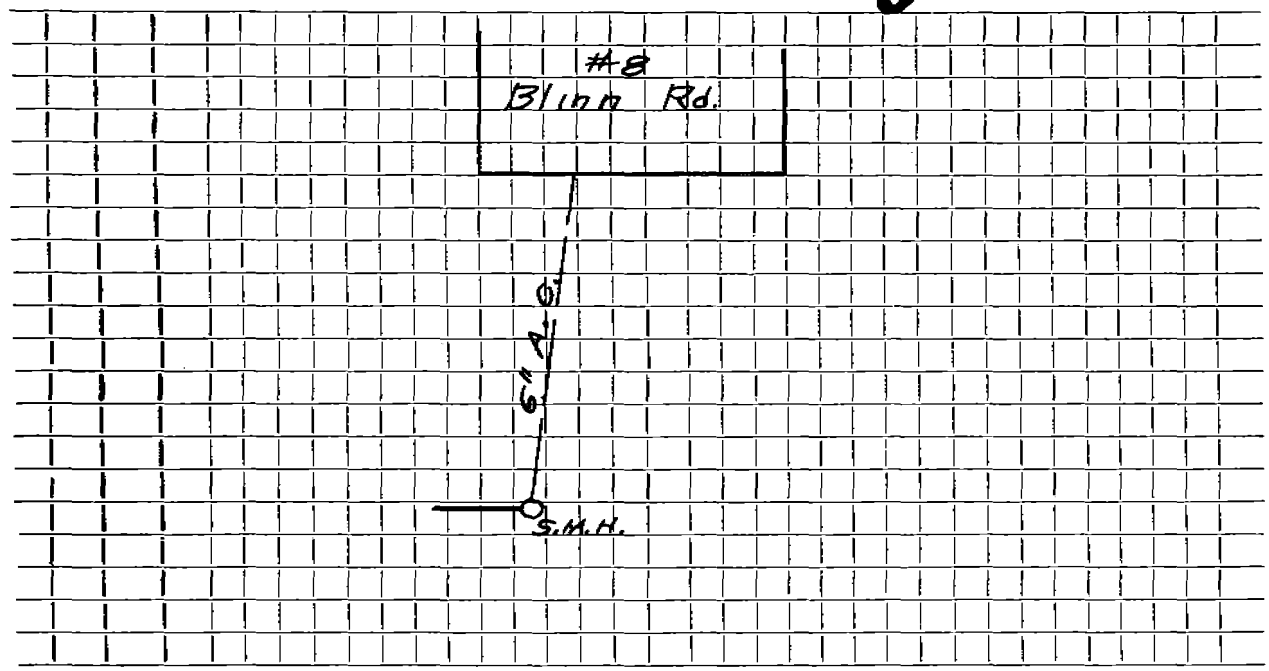

Connection made in Street. Work completed

Remarks:
.....
.....