



LEWISTON — BOARD OF PUBLIC WORKS
SEWER DIVISION

F LEXINGTON — BOARD OF PUBLIC WORKS
SEWER DIVISION

Sketch of Service Here

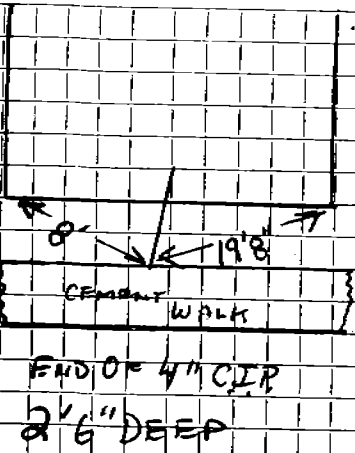

Sketch of Service Here

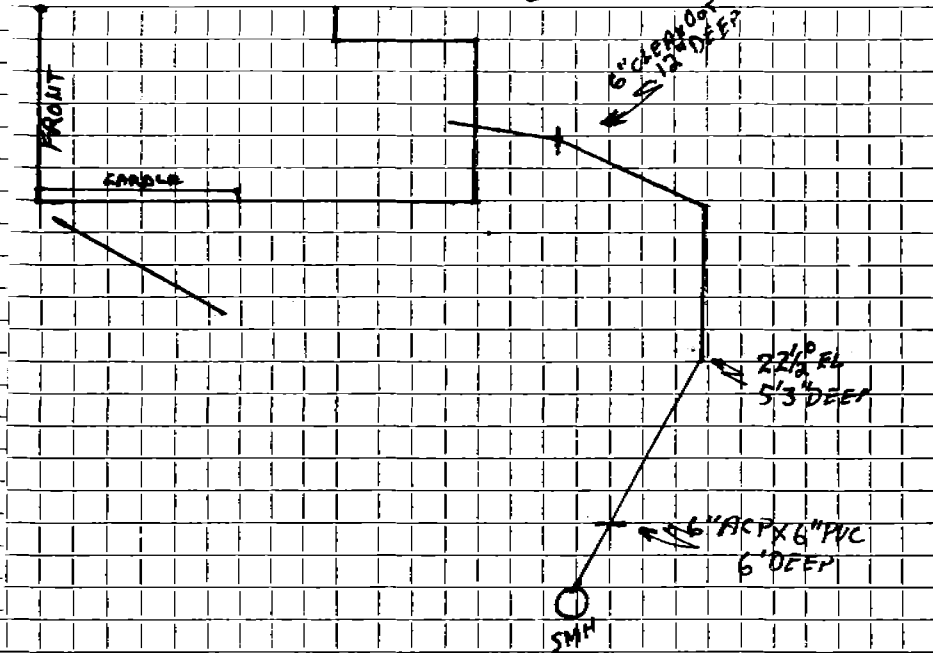

Connection made in APPLETREE LANE Street. Work completed

Remarks: 52 FEET OF 4" VCP UNDER CEMENT WALK AT HOUSE CONNECTED TO A 1" X 6" ACP NIPPLE WITH A 6" ACP X PVC ADAPTER. SEE ATTACHED SHEET FOR TIE AND LOCATION OF 4" CIP