

Name James F. McCann

Service No. 217

Address 11 Blodgett Road

Location

Kind of Pipe

Size

Size of Main

~~REPAIR & RENEWAL~~—New Service

W OFF 8374

Location

Camden 5-18-64


Date	Material	Amount	Total	Date	Amount
10/-/63	16.5' 6" A.C. installed by contractor @6.00 per foot	99 00		12-9-63 6-5-64	350 00 5 46 355 46
	BILL WHEN CONNECTED				
1-6-64	Labor	93.74			
4-21-64	"	35.10	128.84		
	10% O.H.	12.88	141.72		
	80' 6" Transite pipe @.82		65.60		
	1 11 $\frac{1}{2}$ " Transite Bend		4.09		
	Lime & Fertilizer		2.00		
	1 bag Cement		1.55		
	3 hrs. Trucking @3.00		9.00		
	5 hrs. Town Shovel @6.50		32.50		
			355.46		

DATE _____

TOWN OF LEXINGTON — BOARD OF PUBLIC WORKS

SEWER DIVISION

Sketch of Service Here **11**

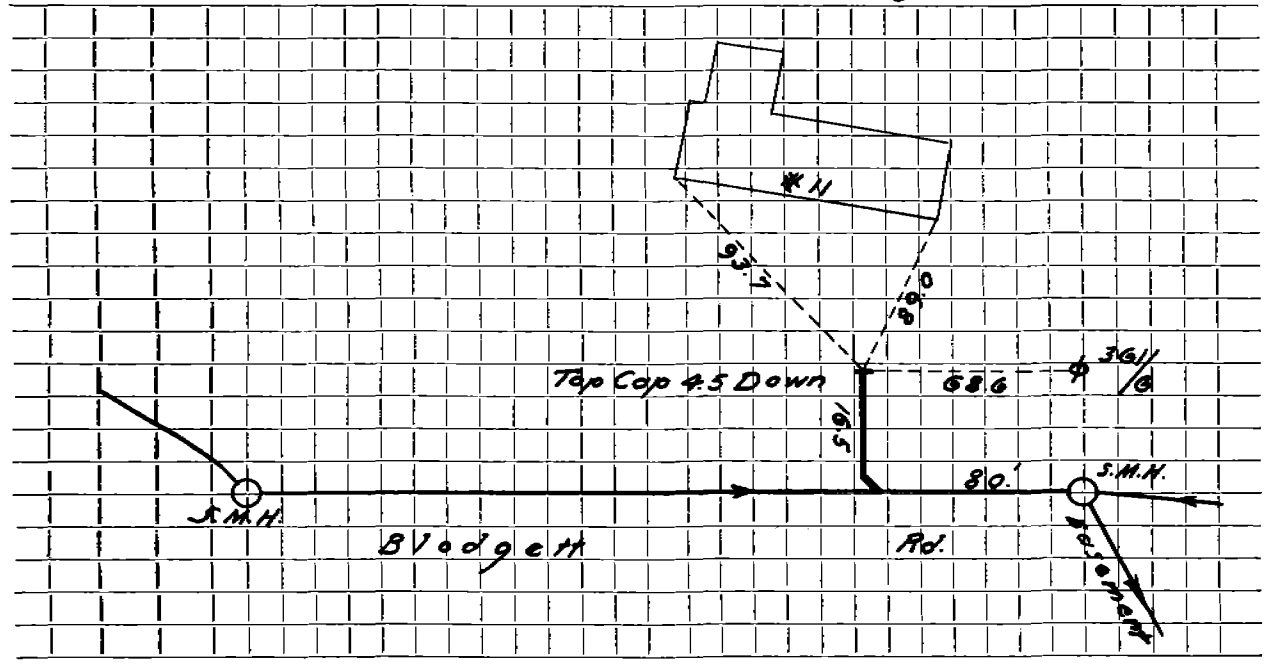

Connection made in Street. Work completed

Remarks: *5 1/2. 0.0.0.0*