

Name Richard W. Nylander

Service No. 37

Address 3 Blodgett Road

Location

Kind of Pipe

Size

Size of Main

Repair—Renewal—New Service Suburbanite #565

Location JUL 24 1967

Date	Material	Amount	Total	Date	Amount
------	----------	--------	-------	------	--------

10/-/63	18' 6" A.C. installed by contractor @6.00 per foot	108 00		5-8-67	<i>Deposit</i> 108 00
BILL WHEN CONNECTED					


5/23/67	40' 6" Transite Pipe				
	10' 4" Cast Iron Pipe				

DATE _____

TOWN OF LEXINGTON — BOARD OF PUBLIC WORKS
SEWER DIVISION

Sketch of Service Here

3

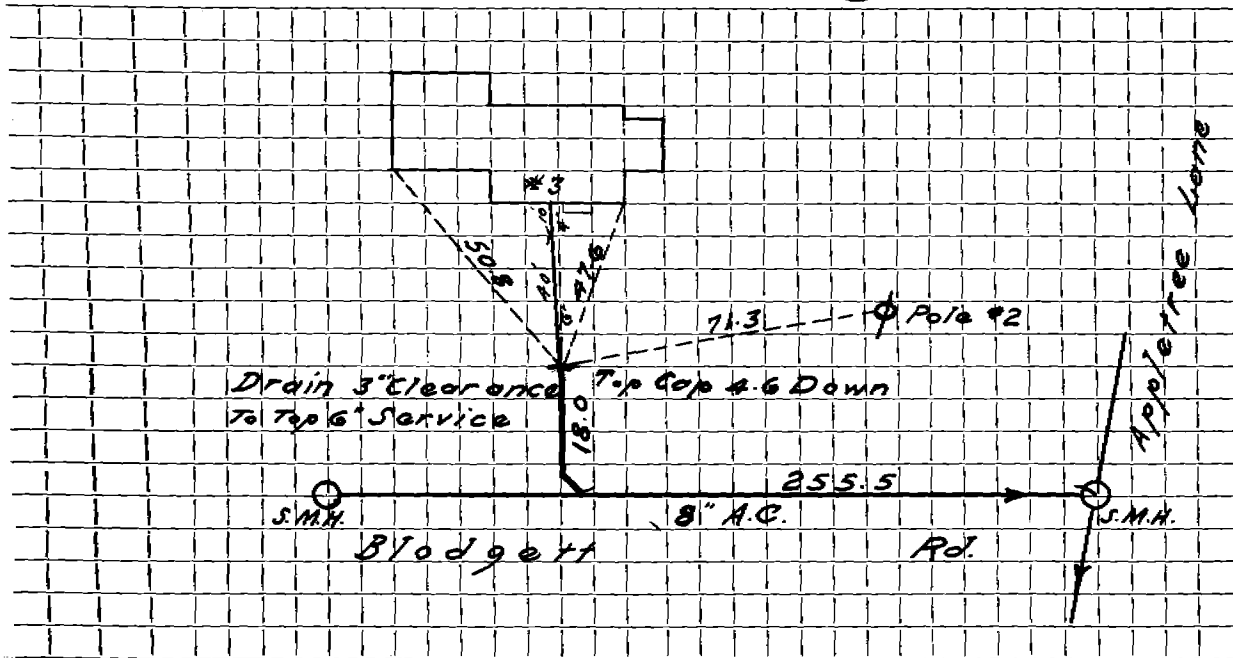

Connection made in Street. Work completed

Remarks:
.....
.....