

Name Woburn Hardware & Supply Co.

Service No. 222

Address 4 Blodgett Road

Location

Kind of Pipe

Size

Size of Main

~~Renewal~~ New Service

W.C.F. 8388

Location Comm 5-18-64

Date	Material	Amount	Total	Date	Amount
10/-/63	15' 6" A.C. installed by contractor @6.00 per foot	90 00		12-16-63 5-18-64	Deposit Retrad 850 00 302 64 547 34
	BILL WHEN CONNECTED				
1-27-64	Labor 96.00				
1-28-64	" 19.38				
4-27-64	" 78.00				
4-28-64	" 11.70	205.08			
	10% O.H.	20.51	225.59		
	165' 6" Transite pipe @.82		135.30		
	1 20" Cesspool Cover & Frame		10.05		
	2 22 $\frac{1}{2}$ " Transite Bands @4.09		8.18		
	2 11 $\frac{1}{4}$ " Transite Bands @4.09		8.18		
	1 22 $\frac{1}{2}$ " Transite Elbow		2.35		
	2 11 $\frac{1}{4}$ " Transite Elbow @2.35		4.70		
	1 Duplex Adapter		1.62		
	2 bags Cement @1.55		3.10		
	200 Sewer Brick @4.20 per 100		8.40		
	16 yds. Loam @3.00		48.00		
	Lime & Fertilizer		1.87		
			547.34		


DATE _____

TOWN OF LEXINGTON — BOARD OF PUBLIC WORKS

SEWER DIVISION

Sketch of Service Here

4

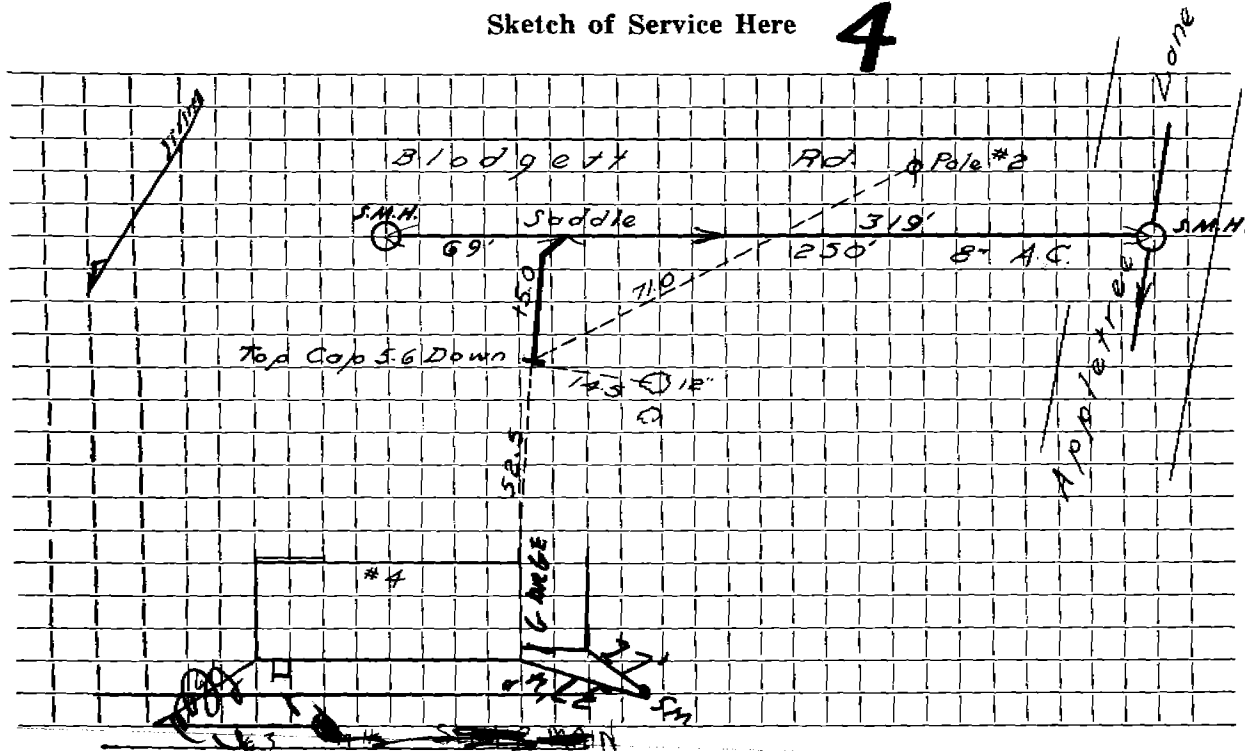

Connection made in Street. Work completed

Remarks:
.....
.....