

Name Herman I. Stroum

Service No. 12

Address 5 Blodgett Road

Location

Kind of Pipe

Size

Size of Main

~~Repair-Reserve~~ New Service

10 CH 8561

Location

Com m 5-18-64


Date	Material	Amount	Total	Date	Amount
10/-/63	16' 6" A.C. installed by contractor @6.00 per foot	96 00		2-14-64 5-18-64	375 00 42 32 332 68
	BILL WHEN CONNECTED				
3-17-64	Labor	80.26			
4-21-64	"	19.50	99.76		
	10% O.H.	9.98	109.74		
	65' 6" Transite pipe @.82		53.30		
	4½ ton 1½" Stone @1.50		6.75		
	1 11¼" Transite Bend		4.09		
	100 Bricks		4.20		
	1 Cesspool Cover & Ring		10.05		
	1 Bag Cement		1.55		
	4 yds. Loam @3.00		12.00		
	3 hrs. Trucking @3.00		9.00		
	4 hrs. Town Shovel @6.50		26.00		
			332.68		

DATE _____

TOWN OF LEXINGTON — BOARD OF PUBLIC WORKS
SEWER DIVISION

Sketch of Service Here

5

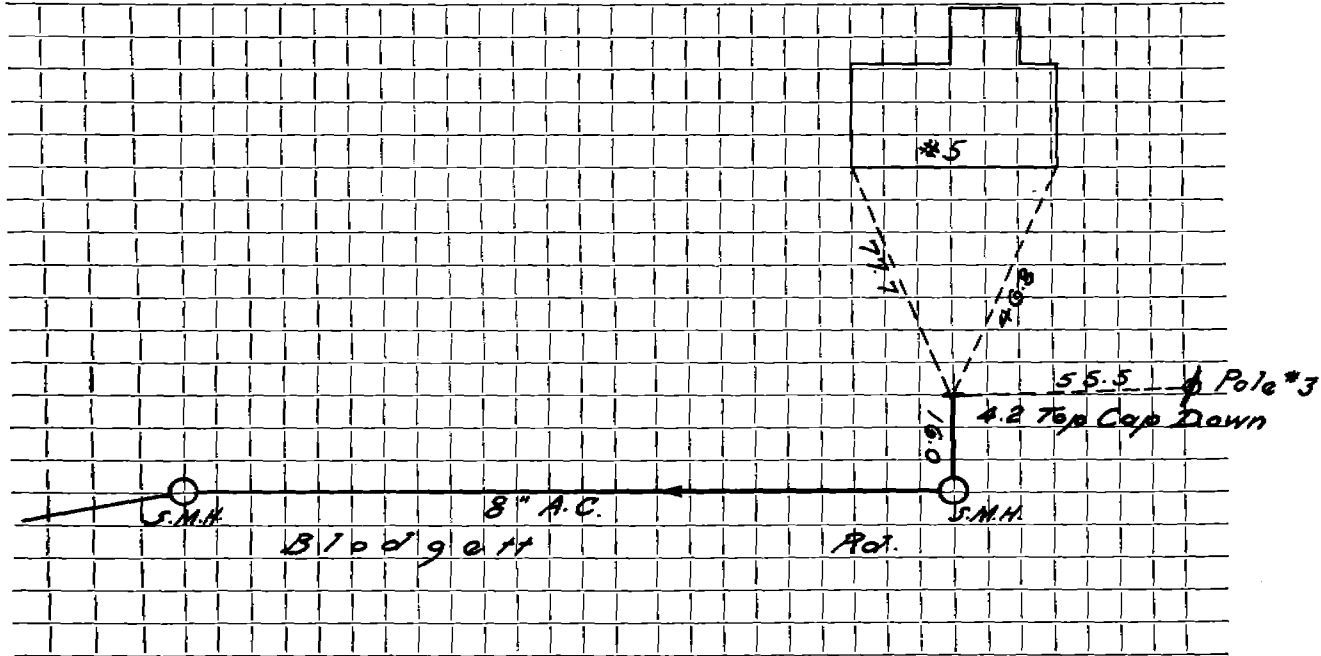

Connection made in Street. Work completed

Remarks:
.....
.....