

Name

Service No.

Address 7 Blodgett Road

Location

Kind of Pipe

Size

Size of Main

Repair—Renewal—New Service


Location

Date	Material	Amount	Total	Date	Amount
10/--/63	17' 6" A.C. installed by contractor @6.00 per foot BILL WHEN CONNECTED	102 00			

DATE \_\_\_\_\_

TOWN OF LEXINGTON — BOARD OF PUBLIC WORKS  
SEWER DIVISION

Sketch of Service Here **7**

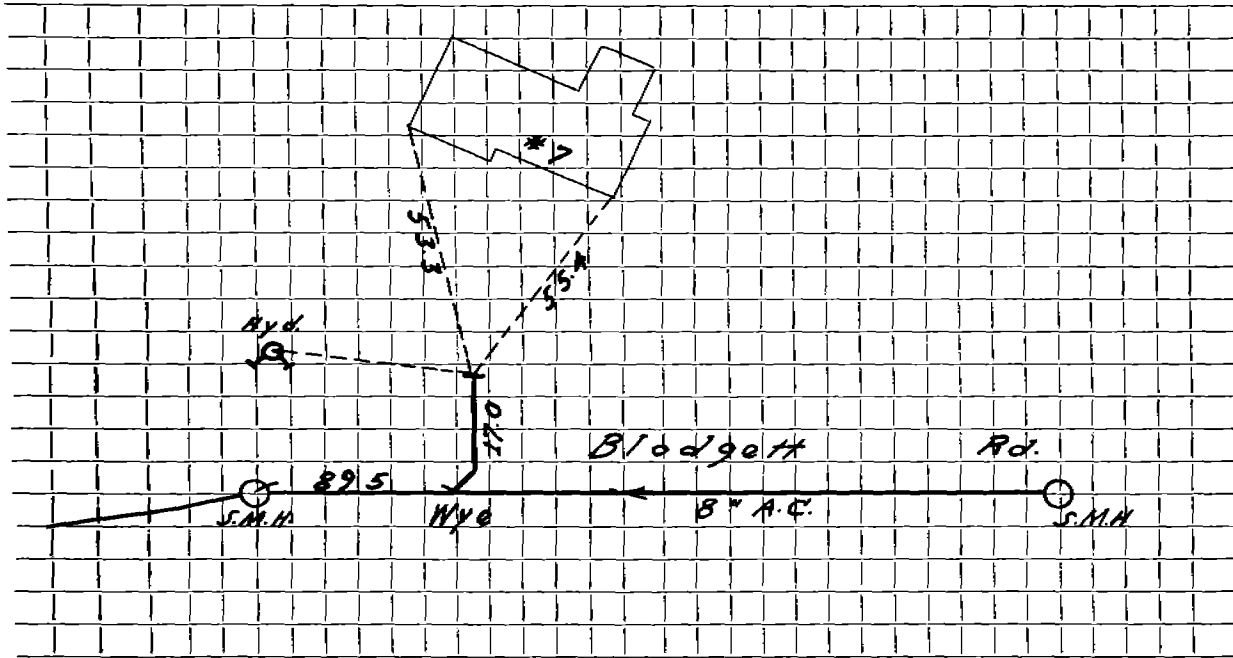

Connection made in ..... Street. Work completed .....

Remarks: .....  
.....  
.....




DATE MAY 11 1998

TOWN OF LEXINGTON — BOARD OF PUBLIC WORKS

SEWER DIVISION

Sketch of Service Here

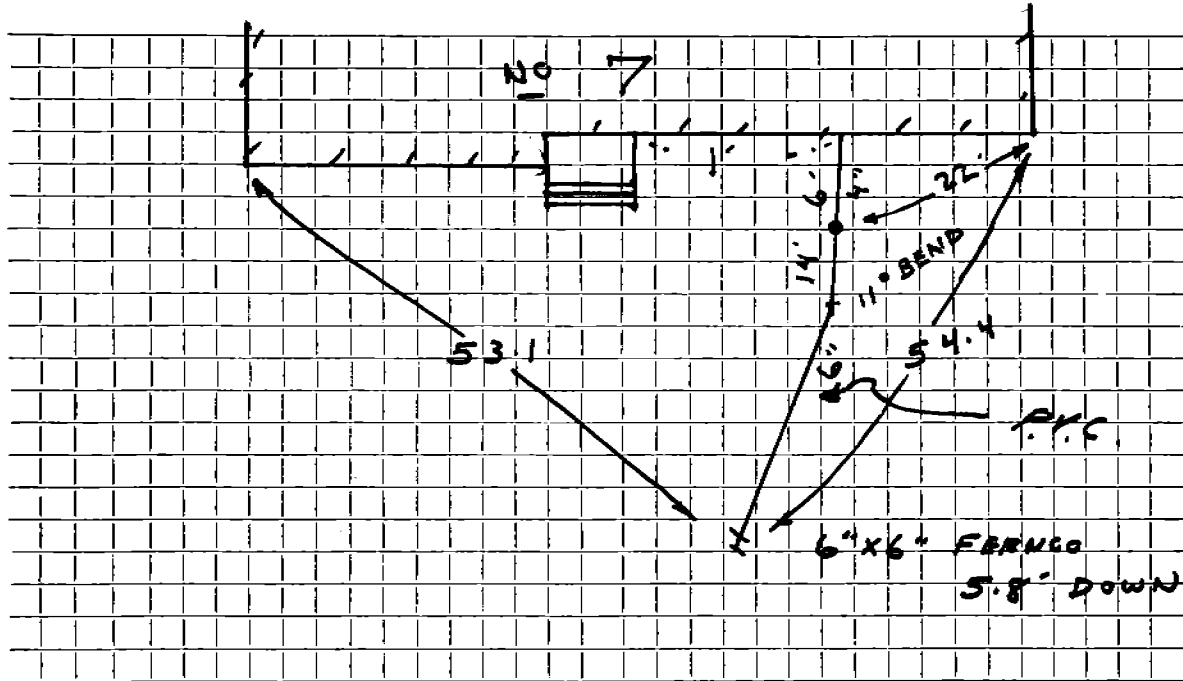

Connection made in BLODGETT PD Street.

Work completed D. SANTOS

Remarks: .....

FIELD BOOK 98-1

TJM