

Name Charles H. Ehlers

Service No. 141

Address 8 Blodgett Road

Location

Kind of Pipe

Size

Size of Main

~~Repair/Removal~~—New Service N.O.#9144

Location FEB 15 1965


Date	Material	Amount	Total	Date	Amount
11-10-64	Labor 80.95			8-21-64	250 00
11-13-64	Labor <u>35.36</u>	116 31		3-15-65	3 82
	10% O. H.	11 63	127 94		2.53 82
65'	6" Transit Pipe @ .82		53 30		
1	6 x 8 Saddle		5 25		
1	90° Elbow		4 09		
1	Duplex Adapter		2 06		
1	1 1/2 Bend		4 09		
1	22 1/2 Bend		4 09		
5	Yds Loam @ 3.00		15 00		
4	Hrs Town Shovel @ 6.50		26 00		
4	Hrs Town Truck @ 3.00		12 00		
			<u>253 82</u>		
					Bill sent 3 22

DATE _____

TOWN OF LEXINGTON — BOARD OF PUBLIC WORKS
SEWER DIVISION

Sketch of Service Here

8

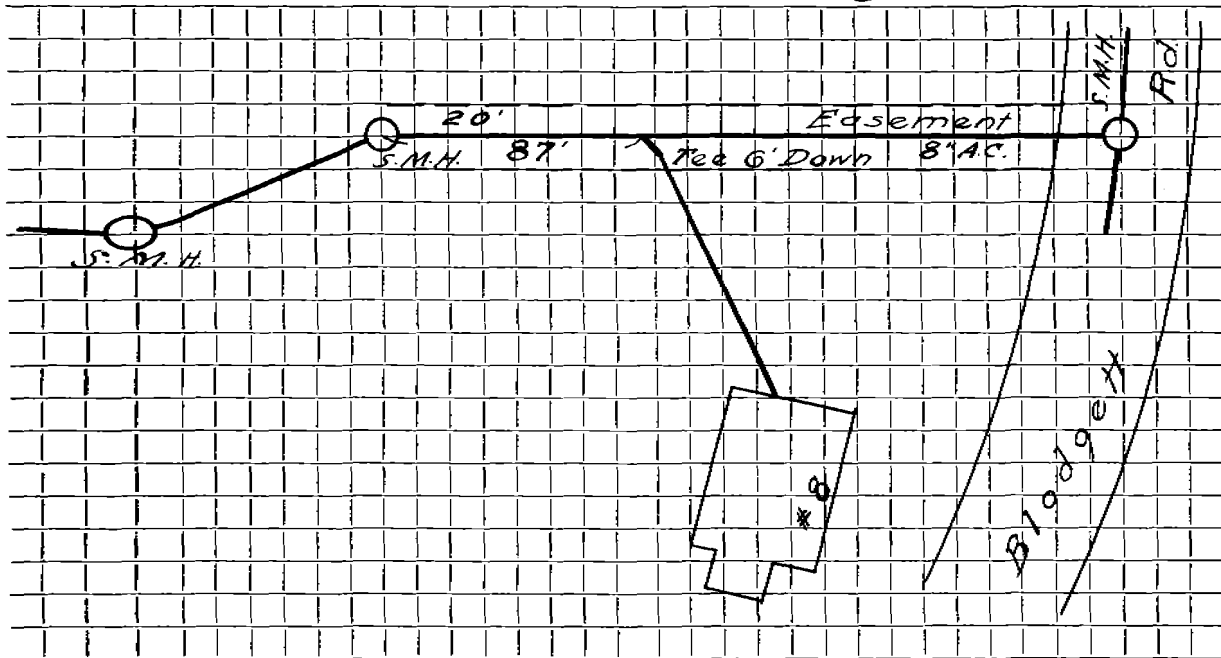

Connection made in Street. Work completed

Remarks:

.....

.....