

Name Edward F. McLaughlin, Jr.

Service No. 90

Address 9 Blodgett Road

W.O. #8764

Location 9 Blogett Road

Kind of Pipe

Size

Size of Main

~~REPAIR EXISTING~~ New Service

Location


DEC 28 1964

Date	Material	Amount	Total	Date	Amount
10--/63	21.5' 6" A.C. installed by contractor @6.00 per foot	129 00		5-18-64 2-1-64	300 00 29 22 329 22
	BILL WHEN CONNECTED				
7-1-64	Labor	98.87			
8-24-64	"	27.06	125 93		
	10% O.H.	12 59	138 52		
	35' 6" Transite Pipe @.82		28 70		
	1 Bag Cement @1.50		1 50		
	3 Hrs. Town Shovel @6.50		19 50		
	4 Hrs. Trucking @3.00		12 00		
			329 22		

DATE _____

TOWN OF LEXINGTON — BOARD OF PUBLIC WORKS
SEWER DIVISION

Sketch of Service Here **9**

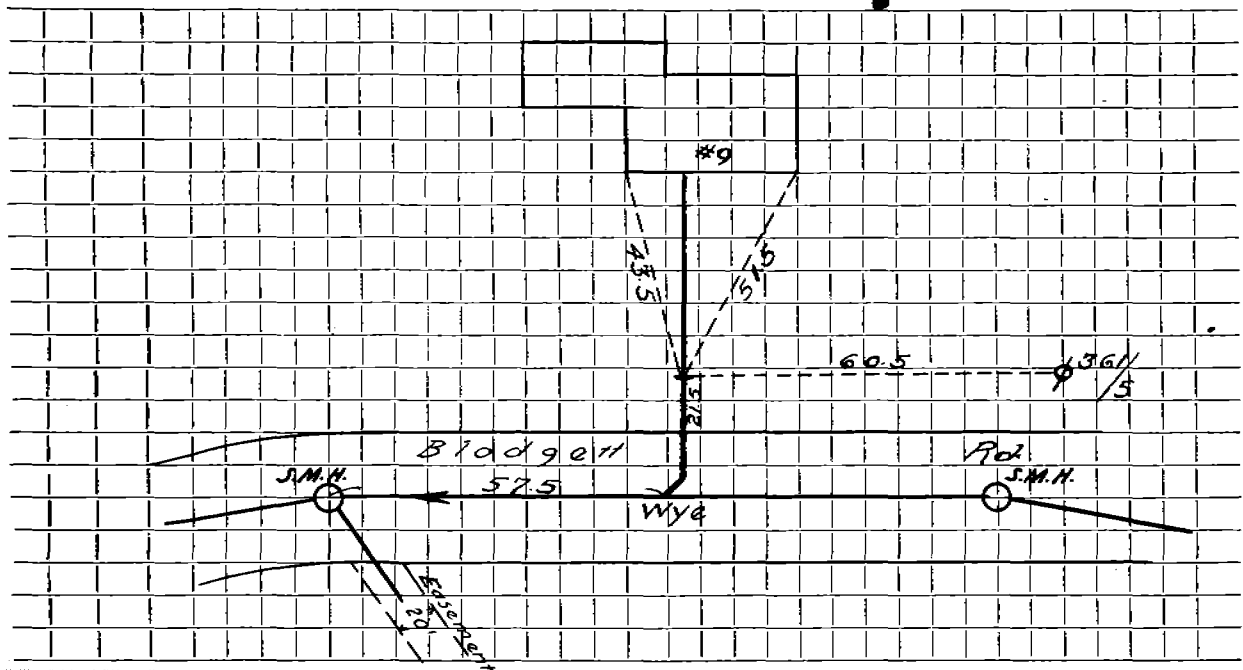

Connection made in Street. Work completed

Remarks:
.....
.....