

Name James Phillips

Service No. 48 1015

Address 10 Bloomfield Street

Location 10 Bloomfield St.

Kind of Pipe

Size

Size of Main

Repair—Renewal—New Service

Location

Date	Material	Amount	Total	Date	Amount
Oct. 13, 44	Labor	34 35			
	"	36 00	70 35	Jan 8' 45	106 36
	10% Overhead		7 04		
	60' 6" Sewer Pipe @.22		13 20		
	1 6" 1 1/4 Bend		67		
	Joint Compound		3 60		
	Trucking 8 hrs. @.75		1 50		
	Patching		10 00		
			106 36		
	Labor				

*No Report
Send*

TOWN OF LEXINGTON—DEPT. OF PUBLIC WORKS

SEWER DIVISION

DATE


NO.

The undersigned applies for the construction of a particular sewer connecting No.
Street and hereby agrees to comply with the Rules and Regulations governing the construction and use of Particular
Sewers, as now or at any future time established by the Board of Selectmen.

Am't of estimate \$.....

Am't Paid \$.....

..... Owner

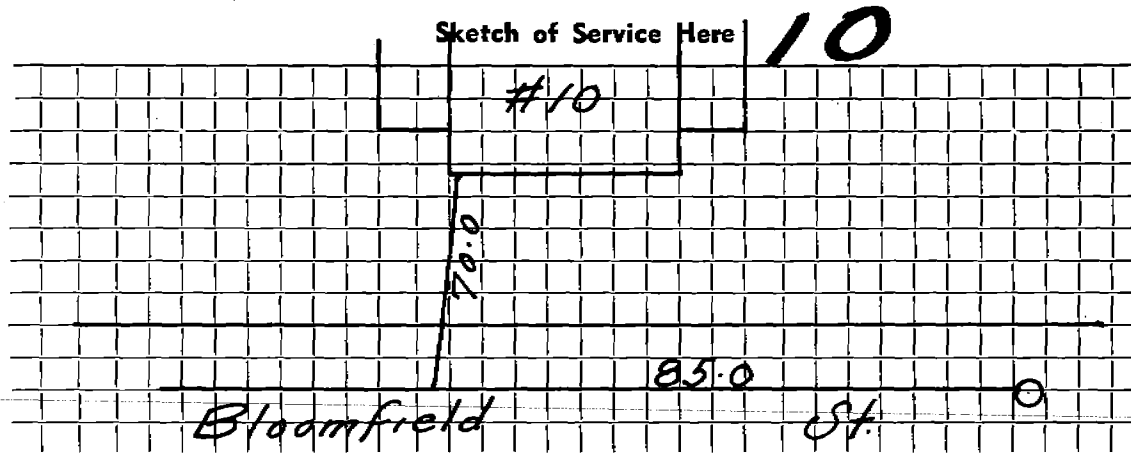

Connection made in Street.

Work completed 19..

Remarks: