

Name Florence Hamlin

Service No. 68

Address 15 Bloomfield Street

Location

Kind of Pipe

Size

Size of Main

~~Repair~~—Renewal—~~New Service~~

W.O. #8025


Location Comm 10-28-63

Date	Material	Amount	Total	Date	Amount
	<i>Outside</i>				
6-17-63	Labor	83.42		6-14-63	Deposit 300.00
	10% O.H.	8.34	91.76	10-28-63	Refund 116.14
	14' 6" Transite Pipe @.82		11.48		183.86
	1 Duplex Adapter		1.62	10-2-28	Inside
	9 x 20 Patch		60.00		62' 6" V.C. Pipe
	2 hrs. Town Shovel @6.50		13.00		10' 4" Iron Pipe
	2 hrs. Trucking @3.00		6.00		
			183.86		

DATE \_\_\_\_\_

**TOWN OF LEXINGTON — BOARD OF PUBLIC WORKS**  
**SEWER DIVISION**

Sketch of Service Here

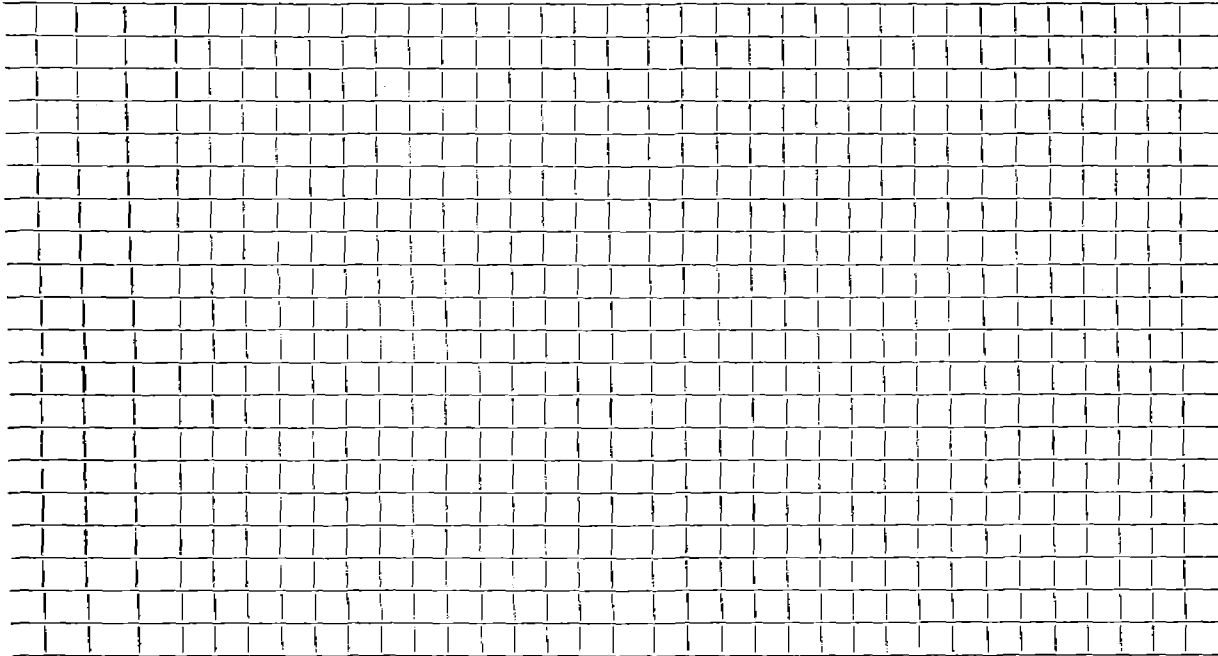

Connection made in ..... Street. Work completed .....

Remarks: .....  
.....  
.....