

Name Sol Hartman

Service No.

Address 16 Bloomfield Street

Location

Kind of Pipe

Size

Size of Main

~~Repair~~—Renewal—~~New Service~~ D. F. Faulkner #4125

Location


Date	Material	Amount	Total	Date		Amount
10/14/26	60' 4" Sewer Pipe					
	10' 4" Soil Pipe					
4/25/85	30' 6" PVC Pipe				OUTSIDE	
	9' 4" C.I. Pipe			3/9/55	Labor	13.44
	1 4" x 6" C.I. to P.V.C. Fernco			3/10/55	"	25.25
	1 6" x 4" P.V.C. to Clay Fernco			3/11/55	"	18.52
				3/14/55	"	18.52
					12' 4" Sewer Pipe @ .32	3.84
					Joint Compound	.72
					8 2/3 hrs. Littlefield Shovel	
					@7.50	65.00
					3 hrs. Trucking @ 756	2/25
						147.54

DATE _____

TOWN OF LEXINGTON — BOARD OF PUBLIC WORKS
SEWER DIVISION

Sketch of Service Here

16

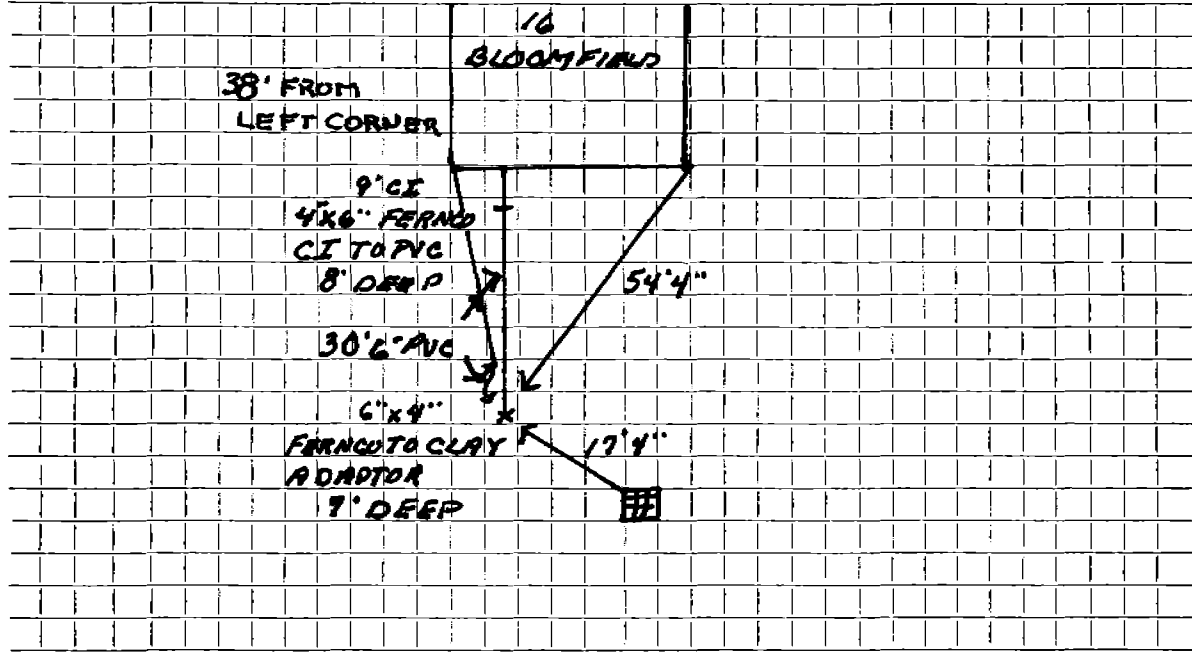

Connection made in Street. Work completed

Remarks:
.....
.....