

Name

Mrs. Mabelle Tower

Service No. 48 89

Address

23 Bloomfield St.

Location

Kind of Pipe

Size

Size of Main

~~Repair~~ ~~Renewal~~ New Service

Location

Date	Material	Amount	Total	Date	Amount
Comm. 107.09	55' 6" Sewer Pipe @.25	13 75			
5-4-31	10' 4" Iron " @.50	5 00			
	Sulphur & Jute	2 20			
	Trucking	75	21 70		
13/31	129 Hrs. Labor @.55	70 95			
8	" " @.60	4 80	75 75		
	15% Overhead		10 64		
			108 09		
	Labor is for water & sewer				
				1-16-67	ROOTS

Aug. 26 1931 - Cash

108 09

idley Press, Inc., Lexington

TOWN OF LEXINGTON—BOARD OF PUBLIC WORKS
SEWER DIVISION

DATE June 3, 1931

NO. _____


The undersigned applies for the construction of a particular sewer connecting No. 23 Bloomfield St. Street and hereby agrees to comply with the Rules and Regulations governing the construction and use of Particular Sewers, as now or at any future time established by the Board of Selectmen.

Am't. of Estimate \$ 125

Am't. Paid \$ _____

Mabelle C. Tower Owner

Sketch of Service Here

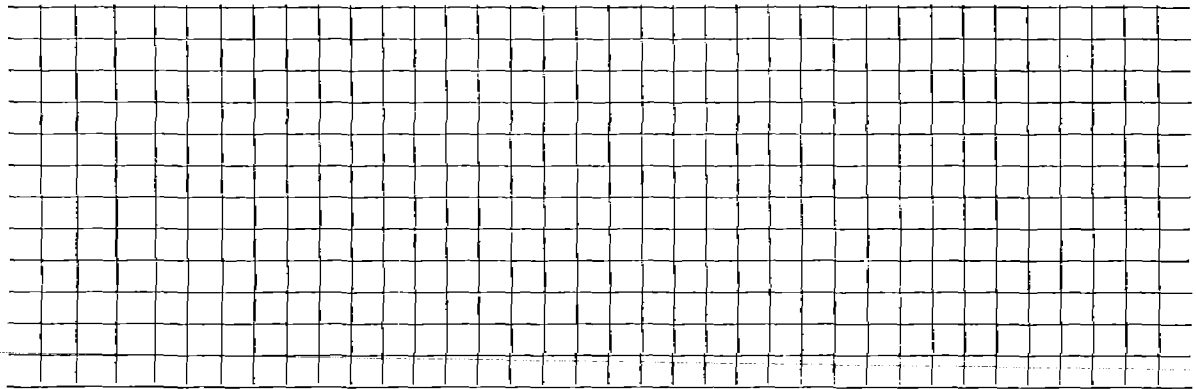

Connection made in _____ Street. Work completed _____ 19

Remarks: