

Name Barrington, James L.

Service No. 25 90

Address 24 Bloomfield St.

Location

Kind of Pipe

Size

Size of Main

~~Repair~~ ~~Renewal~~—New Service

Location

Date	Material	Amount	Total	Date	Amount
1/9/35	75' 6" Sewer Pipe @.15	\$11 25			
	Sulphur & Jute	3 00			
	12 Hrs. Comp. @ 2.50	<u>30 00</u>	\$44 25	<i>Dec. 26 1934 - Deposited</i>	<i>115 -</i>
	181 Hrs. Labor @.50	90 50	<u>90 50</u>	<i>March 11 1935 - Cash</i>	<i>19 75</i>
			\$134 75		<i>134 75</i>
	Labor				

Hadley Press, Inc., Lexington

TOWN OF LEXINGTON—BOARD OF PUBLIC WORKS

SEWER DIVISION

DATE December 27, 1934

NO. _____


The undersigned applies for the construction of a particular sewer connecting No. 24 Bloomfield St. Street and hereby agrees to comply with the Rules and Regulations governing the construction and use of Particular Sewers, as now or at any future time established by the Board of Selectmen.

Am't. of Estimate \$ 115

Am't. Paid \$ 115

James P. Darnington Owner

Sketch of Service Here

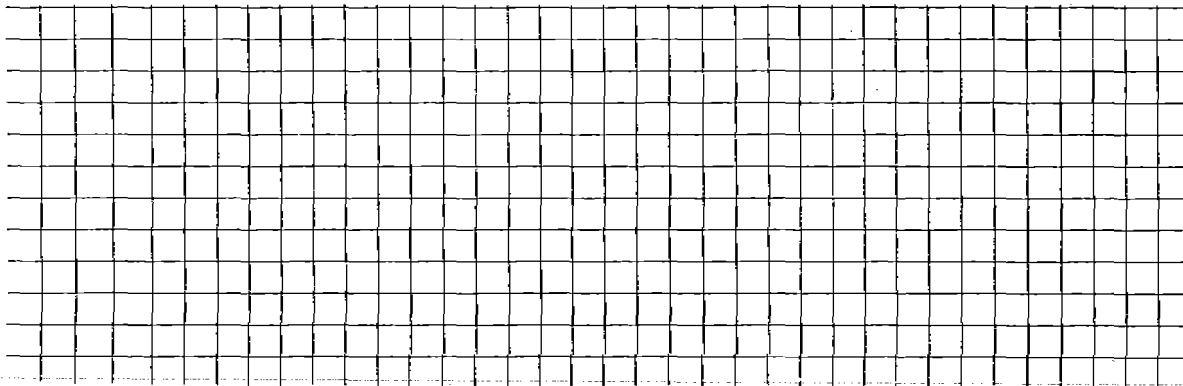

Connection made in _____ Street.

Work completed _____ 19

Remarks: