

Name Thomas S. Grindle

Service No. 3

91

Address 29 Bloomfield Street

Location

Kind of Pipe

Size

Size of Main

~~Repair - Renewal~~ - New Service

Location

Date	Material	Amount	Total	Date	Amount
P. 1-31-28 99.26	63' 4" Sewer Pipe @ .20	12 60			
	Sulphur & Jute	2 52			
	Trucking	<u>1 25</u>	16 37	Feb. 10 1928 - Cash	99 26
	Laid in '26 in street		22 00		
12/22/28	93 Hrs. Labor @ .55	51 15			
3	" " @ .60	<u>1 80</u>	52 95		
	15% Overhead		<u>7 94</u>		
			<u>99 26</u> ✓		
	Labor				

Hadley Press, Inc., Lexington

TOWN OF LEXINGTON—BOARD OF PUBLIC WORKS

SEWER DIVISION

DATE December, 1927

NO. 3


The undersigned applies for the construction of a particular sewer connecting No. 29 Bloomfield St. Street and hereby agrees to comply with the Rules and Regulations governing the construction and use of Particular Sewers, as now or at any future time established by the Board of Selectmen.

Am't. of Estimate \$ _____

Am't. Paid \$ _____

Thos. S. Grindle Owner

Sketch of Service Here

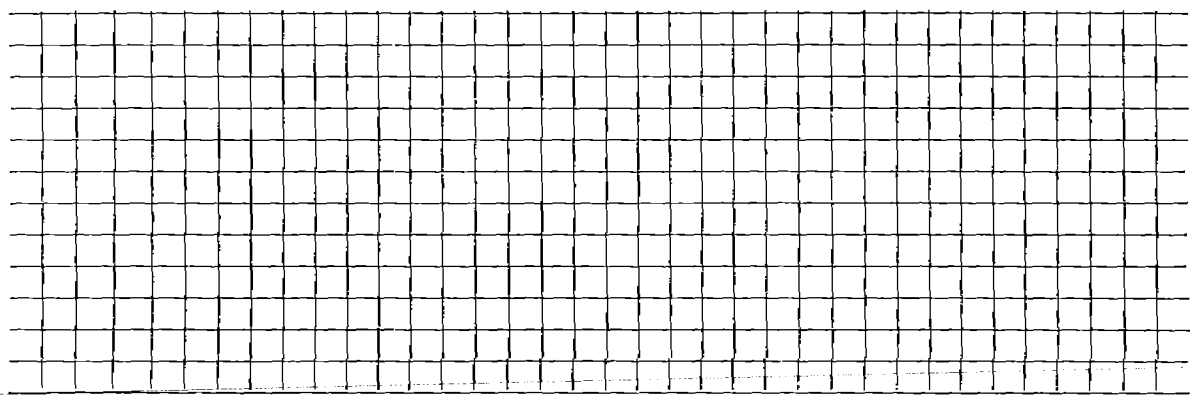

Connection made in Bloomfield Street.

Work completed 12/22/27 19

Remarks: