

Name Selden M. Loring Jr.

Service No. 17

Address 33 Bloomfield Street

Location

Kind of Pipe

Size

Size of Main

Repair—Renewal—New Service W.O.#636


Location NOV 19 1973

Date	Material	Amount	Total	Date	Amount
3/27/73	Labor	105.45		<del>3-27-73</del>	450 00
4/6/73	"	23.74	129.19	11-19-73	47 67
	10% O.H.	12.92	142.11		402 33
	28' 6" Transite pipe @.99		27.72		
	1 11 $\frac{1}{4}$ <sup>o</sup> Bend		3.95		
	8 ton Gravel @1.65		13.20		
	1 yd. Loam		5.00		
	3 lbs. Seed @.95		2.85		
	$\frac{1}{2}$ bag Fertilizer		1.00		
	Patch 14' x 18'		168.00		
	5 hrs. Trucking @3.00		15.00		
	3 hrs. Town Shovel @6.50		19.50		
	1 hr. Loader		4.00		
8-18-47			402.33		
	44' 4" Sewer Pipe				
	1 4" Elbow				

DATE \_\_\_\_\_

TOWN OF LEXINGTON — BOARD OF PUBLIC WORKS  
SEWER DIVISION

Sketch of Service Here **33**

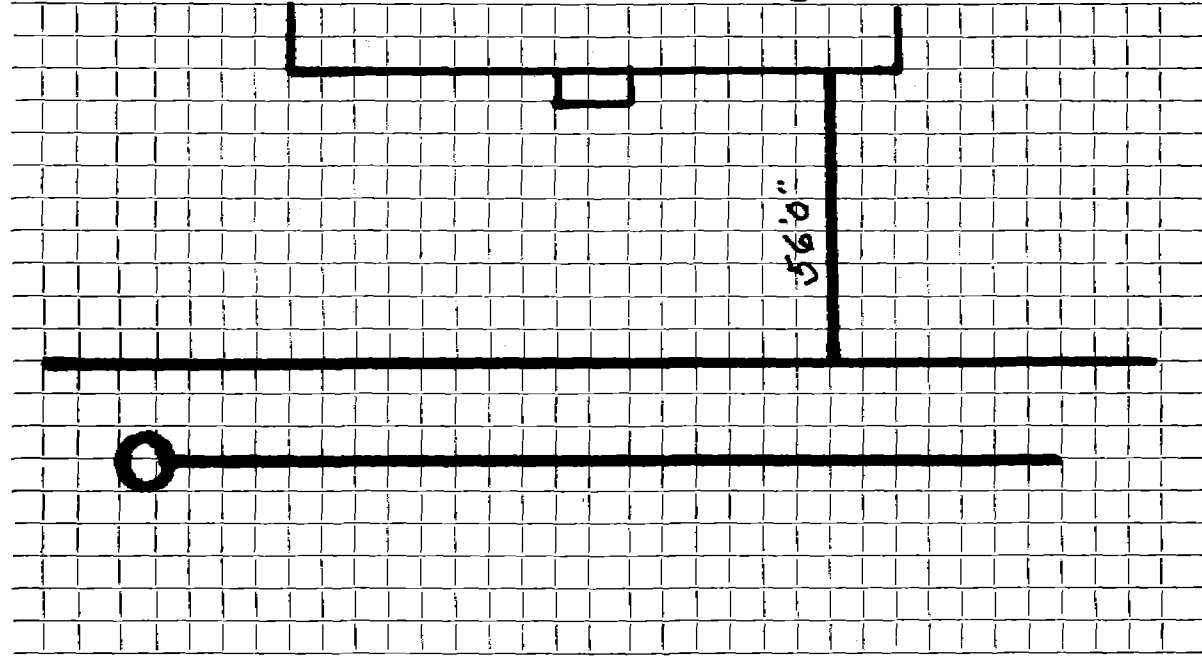

Connection made in ..... Street. Work completed .....

Remarks: .....  
.....  
.....