
Address	41	BI	~~=	P.a.	11	STE	OOT
	_ T_1		<u> </u>	<u> </u>	. .	- O _ L _ Y _	CC .

					Location				
Kind	of P	ipe		Size		Size of Main			
Repa	ir—R	enewal—New Service				Location			
Date		Material	Amount	Total	Date		Amount		
- 3-	26								
	158	6" Sewer Pipe							
	3	6" Bends							

D		-	_							
v	_		ㄷ.	_	_	 	 	 	_	

TOWN OF LEXINGTON - BOARD OF PUBLIC WORKS SEWER DIVISION

Sketch of Service Here

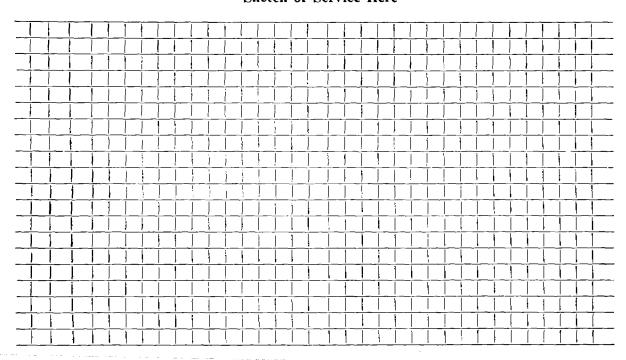

Connection made in	Street.	Work completed
Remarks:		
		.,
	,,,,,,,,,,,,,,,,,,,,,,,,,,,,,,,,,,,,,,,	