

Name Norcross Teel

Service No. 18 1012 (445)

Address 44 Bloomfield Street

Lexington 73, Mass.

Location 44 Bloomfield Street

Kind of Pipe

Size

Size of Main

Repair—Renewal—New Service

Location

Date	Material	Amount	Total	Date	Amount
Jul. 19-24 '45	Labor		246 73	July 19 '45	136 00
	10% Overhead		24 67	Deposited	
	44' - 6" Sewer Pipe @.22		9 68		
	32' - 6" Water Pipe @.98		31 36		
	10' - 4" Soil Pipe @.26		2 60		
	Joint Compound		3 24		
	15 Sticks Dynamite @.10		1 50		
	21 Exploders @.10		2 10		
	Tractor 7 hrs. @2.00		14 00		
	Compressor 13 hrs. @1.75		22 75		
	Trucking 6 hrs. @.75		4 50		
	Labor Patching 20' x 3'		13 32		
			376 45		
HP-6411					

TOWN OF LEXINGTON—DEPT. OF PUBLIC WORKS

SEWER DIVISION

DATE

NO.

The undersigned applies for the construction of a particular sewer connecting No.
Street and hereby agrees to comply with the Rules and Regulations governing the construction and use of Particular
Sewers, as now or at any future time established by the Board of Selectmen.


Am't of estimate \$.

Am't Paid \$.

..... Owner

Sketch of Service Here

44

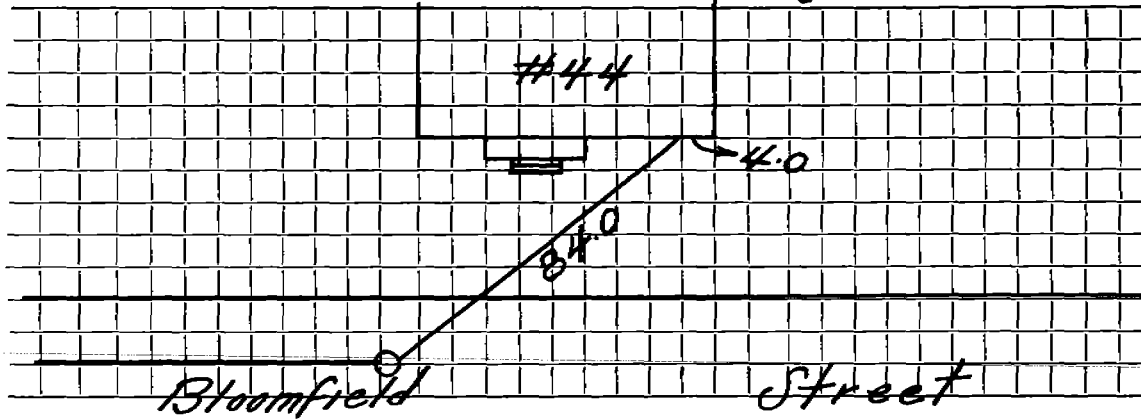

Connection made in Street.

Work completed 19..

Remarks: