

Name Charles H. Peirce
 Address 47 Bloomfield St., Lexington

Service No. 16 95

Location

Kind of Pipe

Size

Size of Main

Repair—Renewal—New Service

Location

Date
1943

Material

Amount

Total

Date

Amount

Aug. 10,

10 hrs. @ 60¢ 6 00

172 33

July 27, 1943 Deposited
Sept. 22, 1943 Paid

240 00

Cont
9/13/43

138½ hrs. @ 65¢ 90 03

90 03

62 " @ 70¢ 43 40

43 40

30½ " @ 80¢ 24 40

24 40

10 " @ 85¢ 8 50

8 50

17 23

10% Overhead

17 23

110' 6" Sewer Pipe @ 16¢

17 60

1 6" 1/8 Bend

67

Joint. compound

6 60

4 hrs. compressor @ 2.25

9 00

4 " trucking @ 75¢

3 00

Trench repairs

15 83

242 26

2 26

242 26

Labor

TOWN OF LEXINGTON—BOARD OF PUBLIC WORKS

SEWER DIVISION

DATE July 22 1943

NO. _____


The undersigned applies for the construction of a particular sewer connecting No. 47 Bloomfield St. Street and hereby agrees to comply with the Rules and Regulations governing the construction and use of Particular Sewers, as now or at any future time established by the Board of Selectmen.

Am't. of Estimate \$ 246⁰⁰

Am't. Paid \$ _____

Charles H. Peirce Owner

Sketch of Service Here **47**

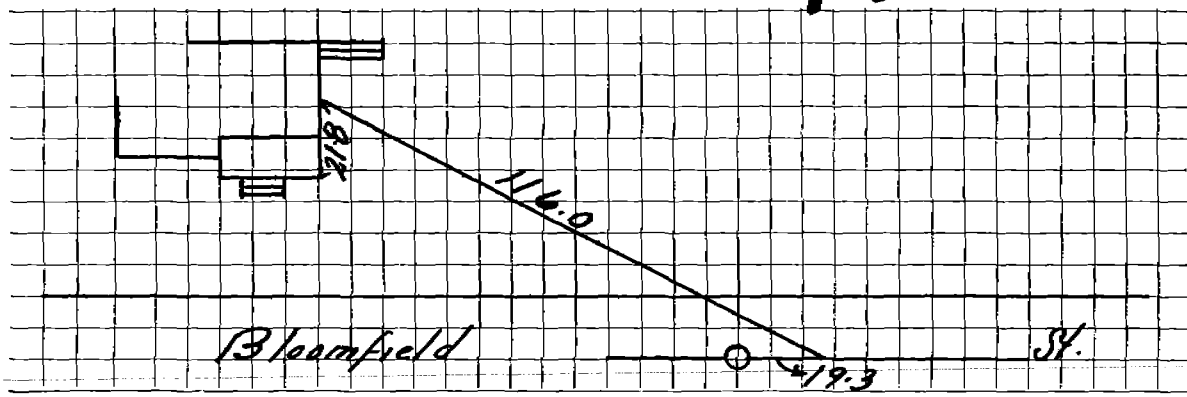

Connection made in _____ Street.

Work completed _____ 19

Remarks: