

Name Mrs. Wilhelmina G. Thomas

Service No. 13 96

Address 50 Bloomfield Street

Location 50 Bloomfield Street

Kind of Pipe

Size

Size of Main

~~Repair~~ ~~Renewal~~ New Service

Location

Date  
1937

Material

Amount

Total

Date

Amount

6/7/37

37½ hrs @ 50¢

18 75

79 98 ✓

June 3 1937

*Deposited*  
*Refunded*

150 80

69½ " 55¢

38 23

87 97

15 17

22 " 60¢

13 20

18 36 ✓

134 83

14 " 70¢

9 80

1 00

10% overhead on labor

5 10 ✓

1 50 ✓

16' in street @ 1.25

134 83

102' 6" Sewer Pipe @ 18¢

1 6" Y

1 4 x 6 increaser

Jointing compound

2 hrs. trucking @ 75¢

Labor

No patching- service laid to curb  
previous to reconstruction of street.

TOWN OF LEXINGTON—BOARD OF PUBLIC WORKS  
SEWER DIVISION

DATE \_\_\_\_\_

NO. \_\_\_\_\_


The undersigned applies for the construction of a particular sewer connecting No. \_\_\_\_\_ Street and hereby agrees to comply with the Rules and Regulations governing the construction and use of Particular Sewers, as now or at any future time established by the Board of Selectmen.

Am't. of Estimate \$ \_\_\_\_\_

Am't. Paid \$ \_\_\_\_\_

\_\_\_\_\_ Owner

Sketch of Service Here **50**

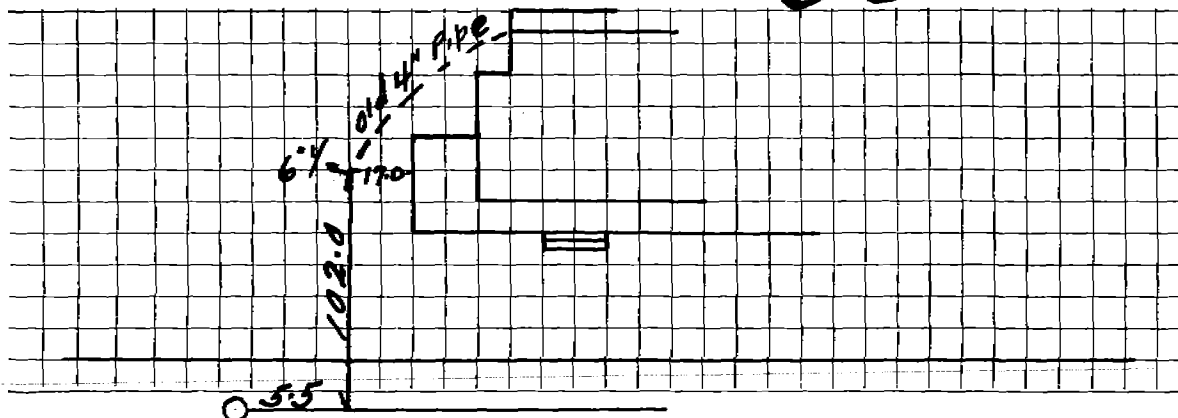

Connection made in \_\_\_\_\_ Street.

Work completed \_\_\_\_\_ 19

Remarks: