

Name George F. Henderson

Service No. 149

Address 51 Bloomfield Street

Location

Kind of Pipe

Size

Size of Main

~~Repair~~—Renewal—~~New Service~~ W. O. # 1417


Location APR 8 1974

Date	Material	Amount	Total	Date	Amount
10/31/73	Labor	216.94		10-19-73	450 00
	10% O.H.	21.69	238.63	4-8-74	60 53
68'	6" Transite @ .90		61.20		389 47
1	"0" Ring		.49		
1/4	bag Cement		.55		
4	yds. Loam @ 5.00		20.00		
18	lbs. Grass Seed @ .95		17.10		
4	hrs. Pickup @ 1.50		6.00		
3	hrs. Trucking @ 3.00		9.00		
1	hr. Loader @ 4.00		4.00		
5	hrs. Town Shovel @ 6.50		32.50		
10-14-30	Original Service		\$389.47		
	140' 6" Sewer Pipe				
	10' 4" Iron Pipe			6-12-73	Roots - Letter Sent 6-12-73
				9-10-70	Roots - Very Bad
				4-1-70	Roots
				7-19-68	Stoppage Cleared

DATE \_\_\_\_\_

TOWN OF LEXINGTON — BOARD OF PUBLIC WORKS  
SEWER DIVISION

Sketch of Service Here **51**

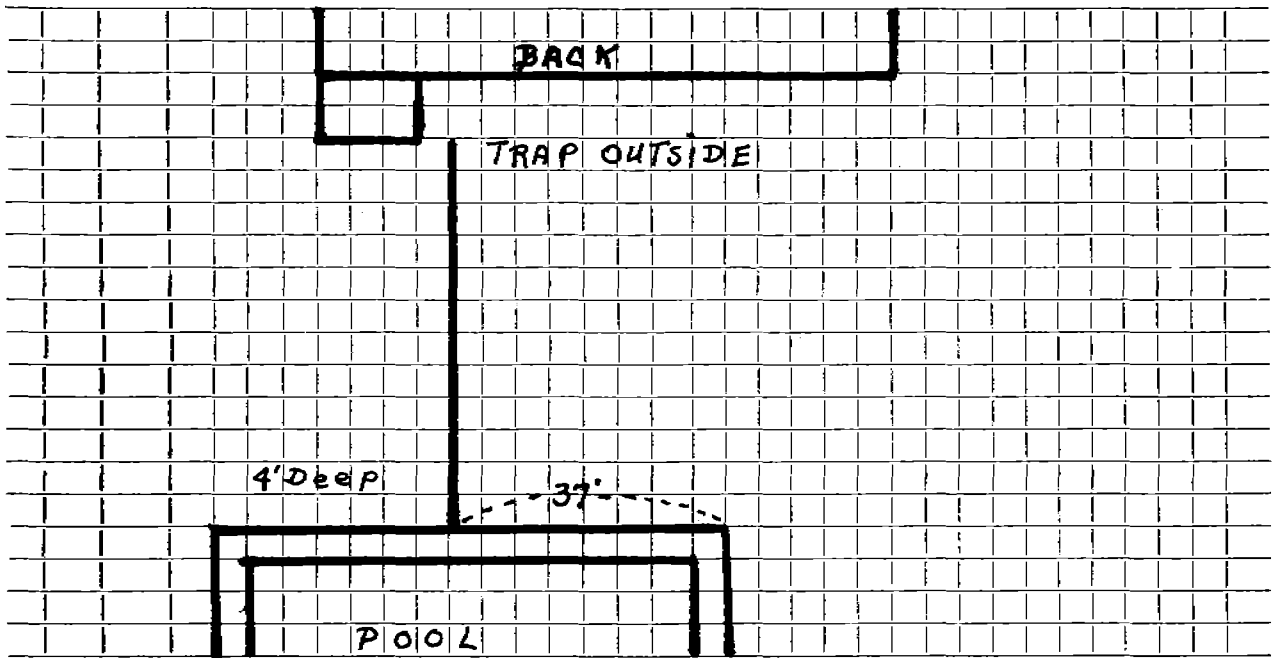

Connection made in ..... Street. Work completed .....

Remarks: .....  
.....  
.....