




DATE August 27, 1985

TOWN OF LEXINGTON — BOARD OF PUBLIC WORKS  
SEWER DIVISION

Sketch of Service Here

56

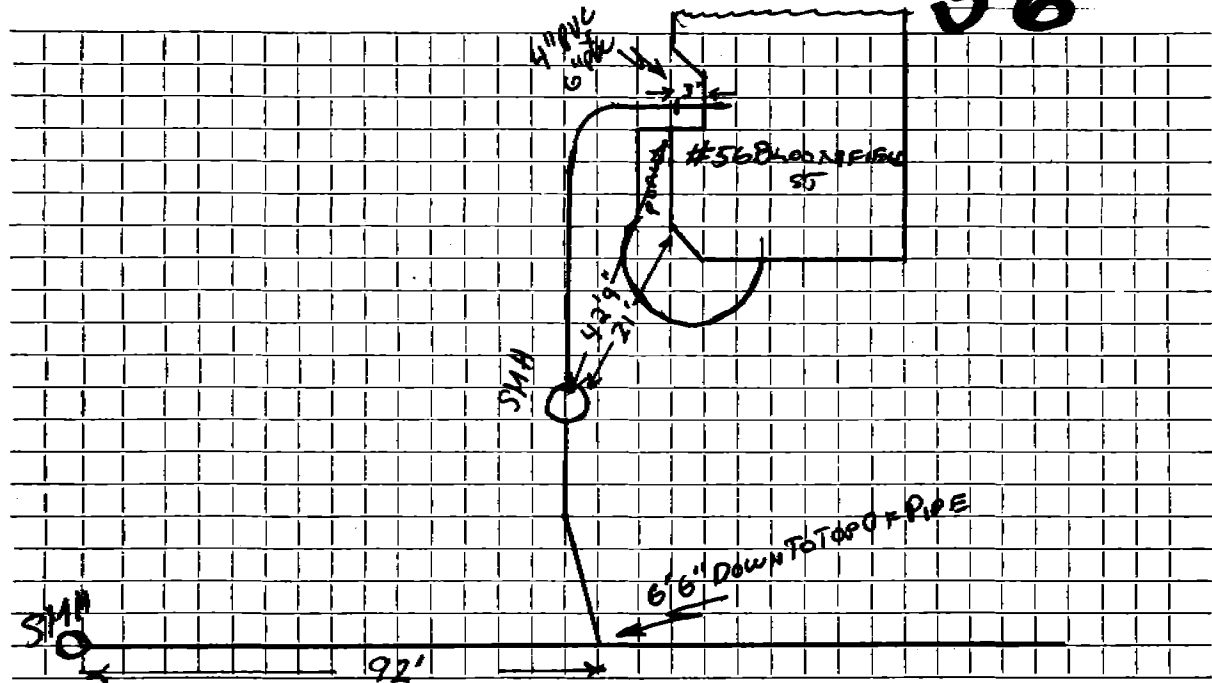

Connection made in BLOOMFIELD ST Street. Work completed AUGUST 27, 1985

Remarks: .....