

Name S & A Realty Trust

Service No.

Address 82 Bloomfield Street

Sta. 0+70L Lot #1

Location

Kind of Pipe Permit #352

Size

Size of Main

~~Repair Service~~ New Service J.M. Lucente

Location


Date		Material	Amount		Total	Date		Amount	
6-25-65	82'	6" Transite pipe							

DATE _____

TOWN OF LEXINGTON — BOARD OF PUBLIC WORKS
SEWER DIVISION

Sketch of Service Here

82

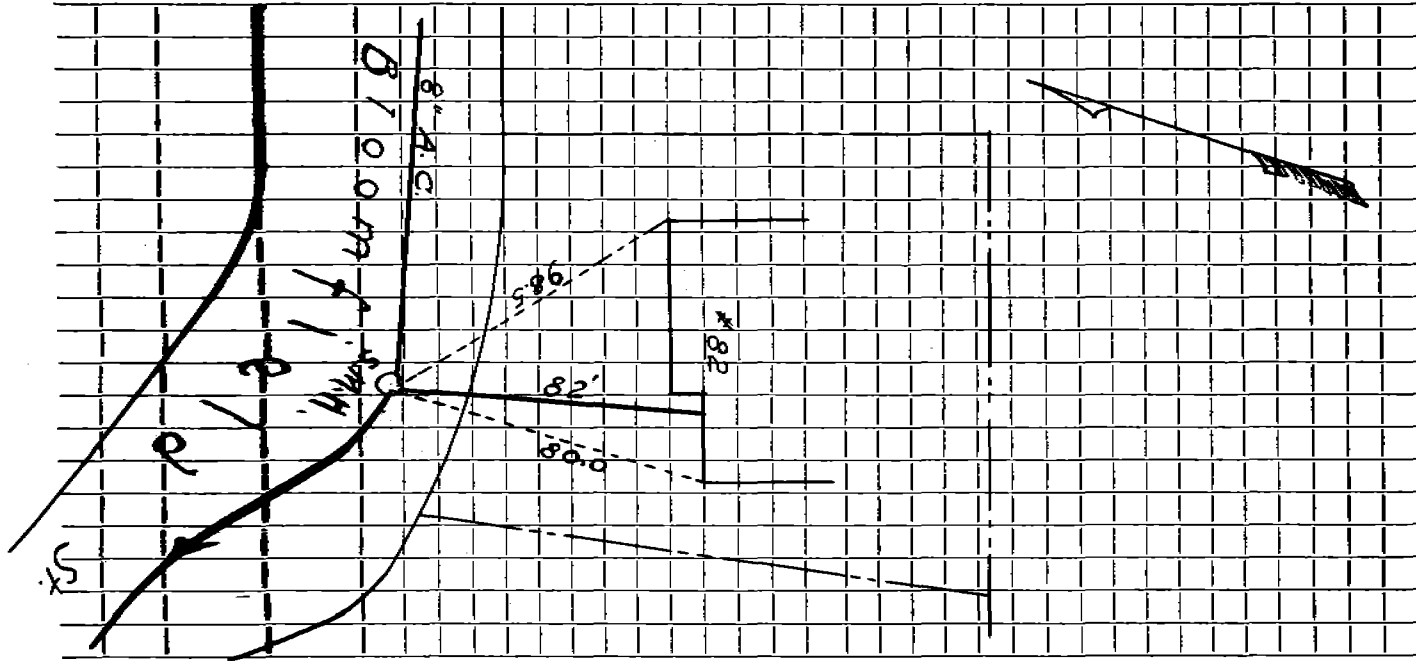

Connection made in Street. Work completed

marks:

.....

.....