

Name S. & A. Realty Trust

Service No.

Address 85 Bloomfield Street

Sta. 2+10R Lot #6

Location

Kind of Pipe Permit #358

Size

Size of Main

~~Repair/Replace~~ New Service J.M. Lucente

Location

Date		Material	Amount	Total	Date		Amount
6-25-65		61.5' 6" Transite pipe					


DATE \_\_\_\_\_

# TOWN OF LEXINGTON — BOARD OF PUBLIC WORKS

## SEWER DIVISION

Sketch of Service Here

85

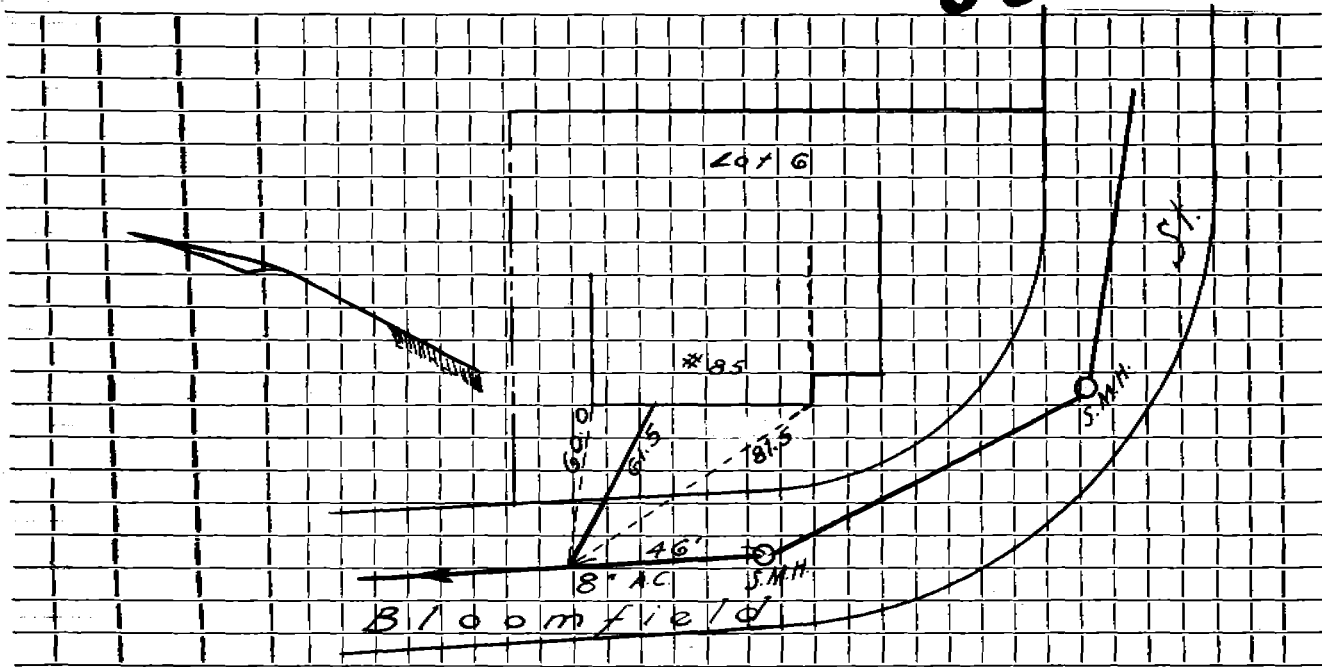

Connection made in ..... Street. Work completed .....

Remarks: .....