

Name S & K Realty Trust

Service No.

Address 86 Bloomfield Street

Sta. 2469L Lot #3

Location

Kind of Pipe Permit #355

Size

Size of Main

~~Repair~~ ~~Work~~ New Service J M Lucente

J.M.Lucente #515

Location


| Date | | Material | Amount | Total | Date | Amount |
|---------|-----|------------------|--------|-------|------|--------|
| 6-25-65 | 26' | 6" Transite pipe | | | | |
| 1/6/67 | | 34' 6" Transite | | | | |
| | | | | | | |
| | | | | | | |
DATE _____

TOWN OF LEXINGTON — BOARD OF PUBLIC WORKS

SEWER DIVISION

Sketch of Service Here **86**

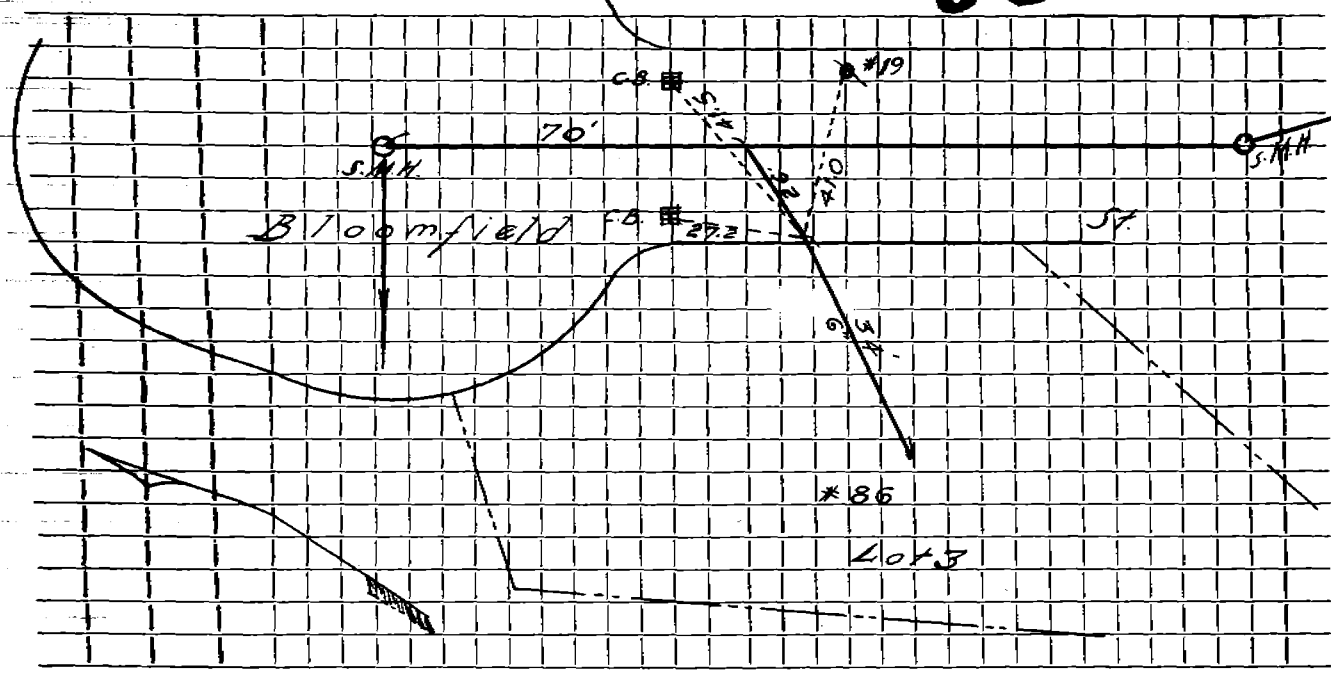

Connection made in Street. Work completed

Remarks: