


DATE 9-3-74

TOWN OF LEXINGTON — BOARD OF PUBLIC WORKS
SEWER DIVISION

Sketch of Service Here

10

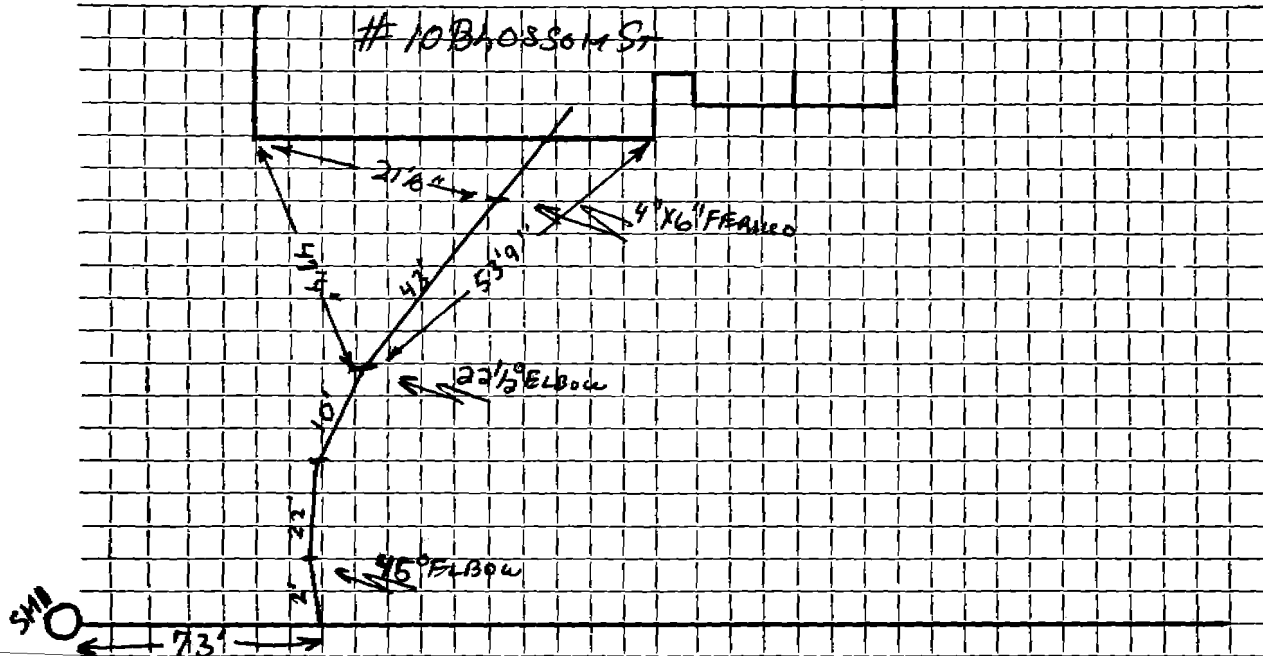

Connection made in BLOSSOM ST Street.

Work completed APRIL 2, 1985

Remarks:

.....

.....