


DATE

TOWN OF LEXINGTON — BOARD OF PUBLIC WORKS

SEWER DIVISION

Sketch of Service Here

14

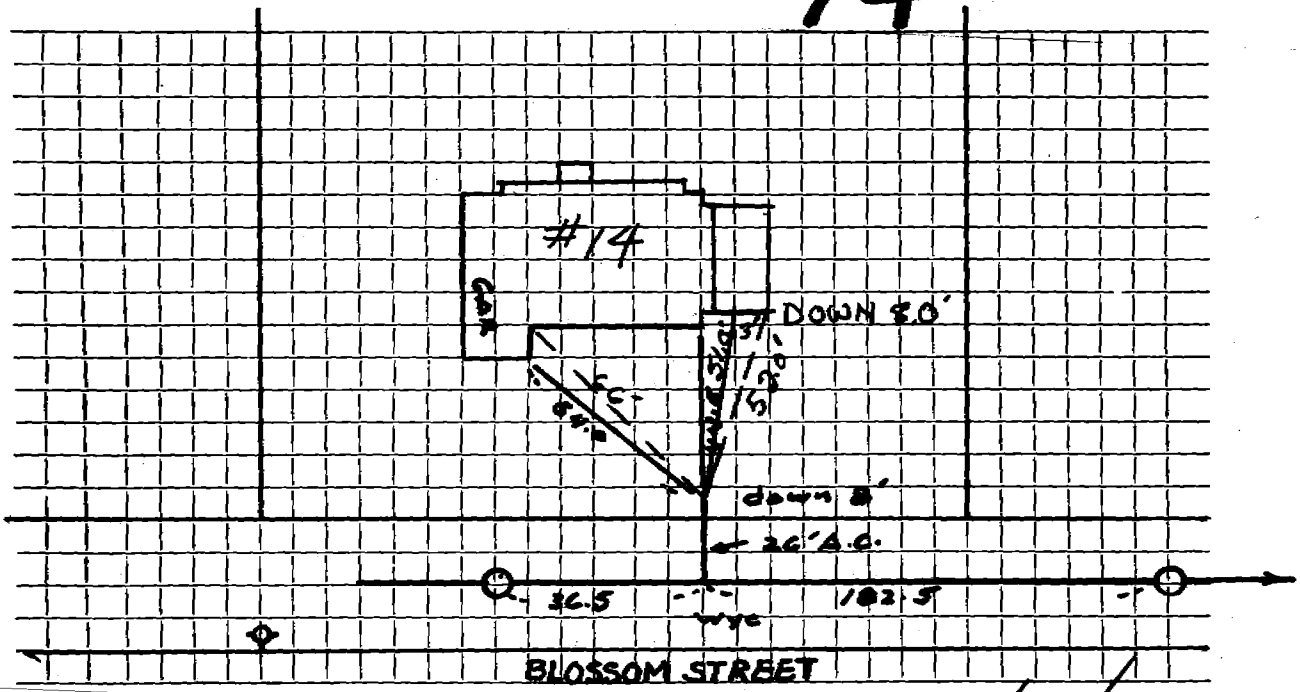

Connection made in W. Blossom St. Street.

Work completed 8/27/75

Remarks: