




TOWN OF LEXINGTON — BOARD OF PUBLIC WORKS

SEWER DIVISION

Sketch of Service Here

A to C - 42.6  
 A to D - 70.3  
 B to C - 45.6  
 B to D - 62.5

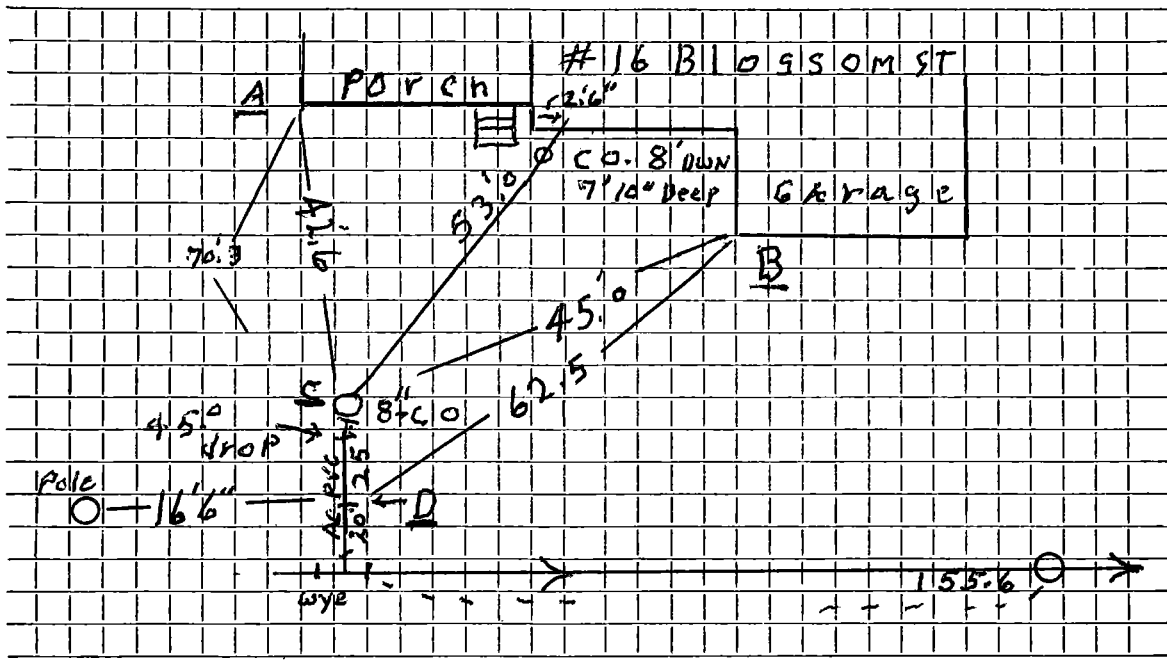

Connection made in ..... Street. Work completed .....

Remarks: 8" Clean out has 45° drop, Depth house side of CO 4'6", @ ST Connection 5' deep

.....

.....