

Name **Chiacchia Family Trust**

Service No. 117(25)

Address **2 Blossom St.**

(See in rec)

Location

Kind of Pipe **A.C.**

Size **6"**

Size of Main **8"**

Repair—Renewal—New Service

Kel-Scott #2762

Location **AUG 16 1976**

Date	Material	Amount	Total	Date		Amount
9/4/74	14' A.C.	\$7.00	\$98.00	10/24/75	Deposit	98.00
10/28/75	423' 6" Transite Pipe					
	10' 4" Cast Iron Pipe					

..B.N.18501


DATE _____

TOWN OF LEXINGTON — BOARD OF PUBLIC WORKS

SEWER DIVISION

Sketch of Service Here

22

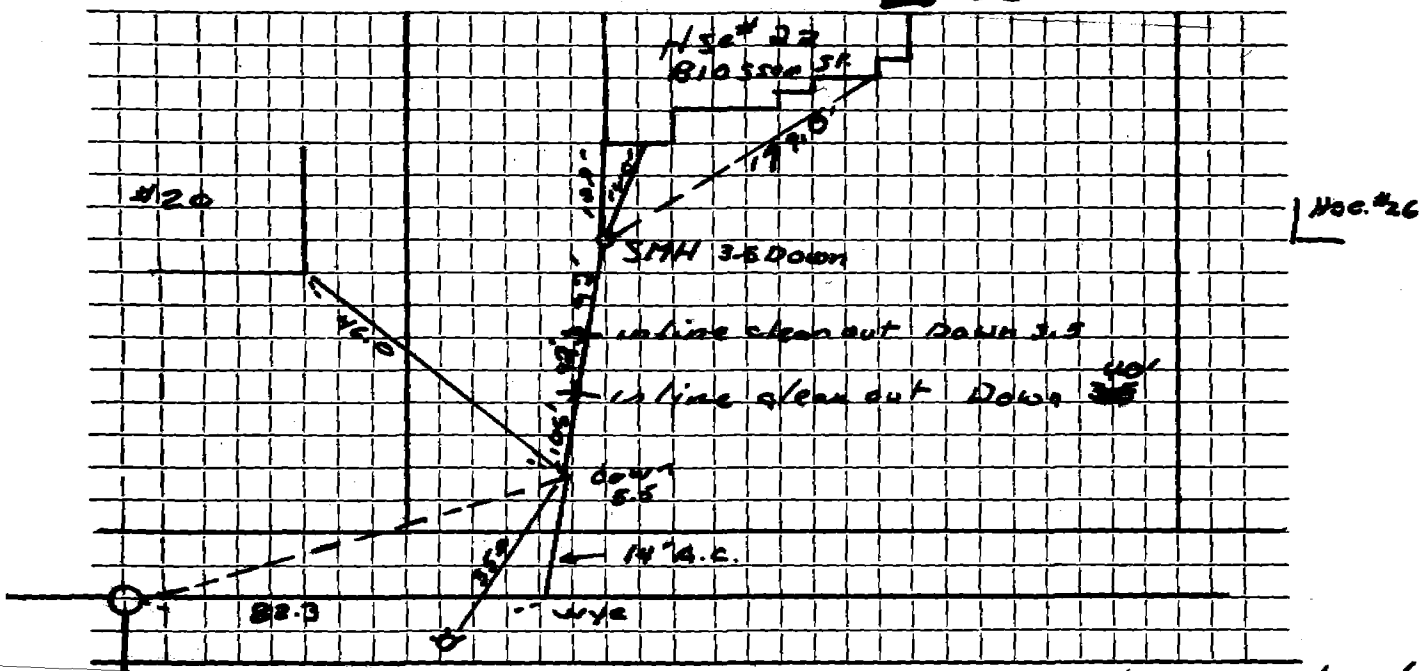

Connection made in 22 Blossom St. Street.

Work completed ~~10/28/75~~ 10/28/75.....

Remarks:
.....
.....