

Name Peter J. Ronchetti

Service No. 120

Address # 4 Blossom Street

Location

Kind of Pipe A.C.

Size 6"

Size of Main 8"

Repair—Renewal—New Service Bruce McKee #2659

Location AUG 16 1976

Date	Material	Amount	Total	Date	Amount
------	----------	--------	-------	------	--------

9/3/74	19.0 A.C.	\$ 7.00	\$ 133.00	11/14/74	Deposit	133.00
--------	-----------	---------	-----------	----------	---------	--------


11/19/74	15' 6" Transite Pipe					
----------	----------------------	--	--	--	--	--

	20' 4" Cast Iron Pipe					
--	-----------------------	--	--	--	--	--

DATE _____

TOWN OF LEXINGTON — BOARD OF PUBLIC WORKS
SEWER DIVISION

Sketch of Service Here **4**

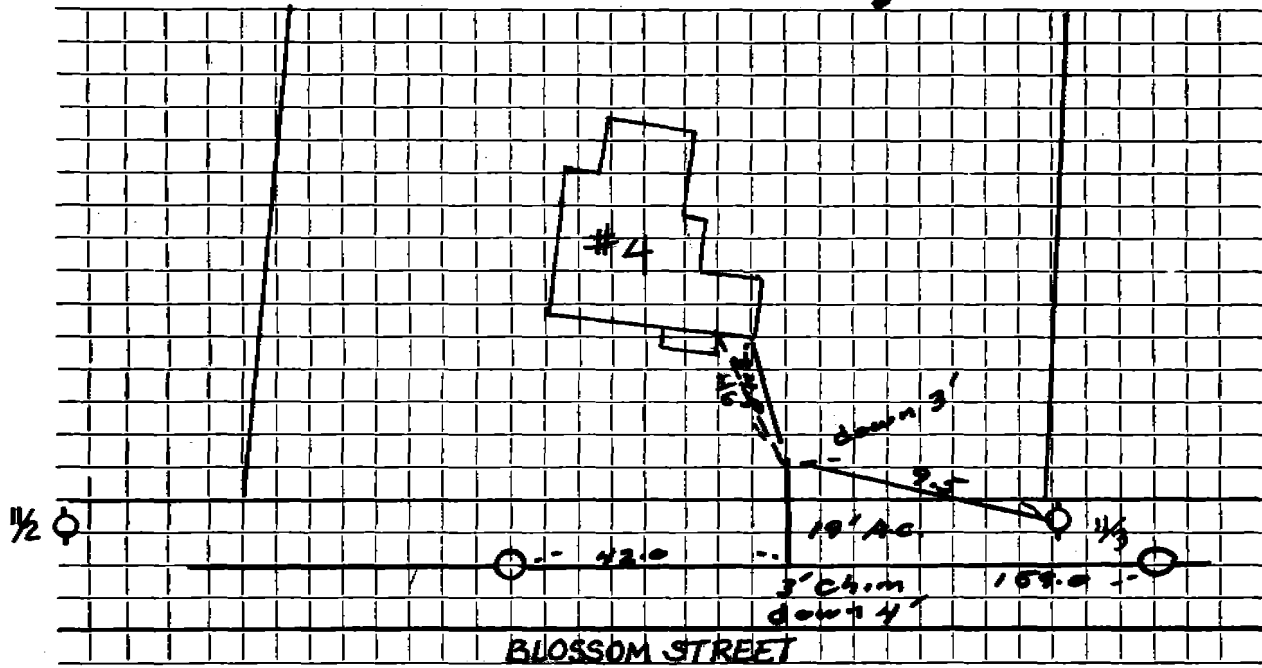

Connection made in #1 Blossom St. Street. Work completed 11/19/74

Remarks:

.....

.....