

Name

Service No.

Address 7 BLOSSUM

Location

Kind of Pipe

SDR35

Size

6" PVC

Size of Main

Repair—Renewal—New Service


Location

Date	Material	Amount	Total	Date	Amount
7/16	- 6" SDR	46'			
"	- CLEAN OUT 6" - 6" SDR RISER - 6" PVC CAP - 6" TEE WYK	2			
"	- PVC 45° BEND (6")	2			
"	- 6' x 6" FERRO AL ⇒ SDR				

DATE 7/20/16

TOWN OF LEXINGTON — BOARD OF PUBLIC WORKS  
SEWER DIVISION

Sketch of Service Here

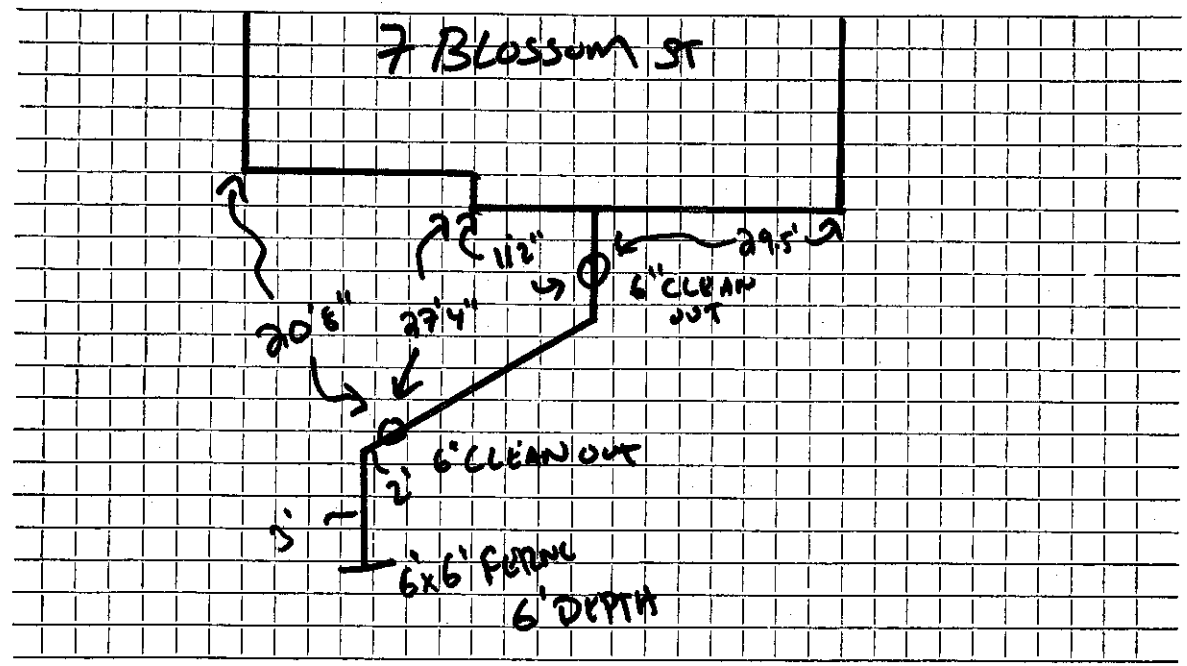

Connection made in D Cossom Street. Work completed FINNEGAN

Remarks: .....

.....

.....