

Name Kenneth Briggs Planning Director

Service No. 123

Address 100 Blossomcrest Road

Location

Kind of Pipe

Size

Size of Main

~~Replacement~~ New Service WO # 4435 Deflice Bros. #2784

Location OCT 25 1976


Date	Material	Amount	Total	Date	Amount
10/31/75	labor	61. 00		10/31/75	150. 00
	10%OH	6. 10	67. 10		
2	10' transite pipes @ 1.48		29. 60		
1	6" X 8" cast iron saddle		14. 90		
1	1 1/2 Elbow		3. 90		
1 1/2	hr. trucking @ 3.00		4. 50		
4	hr. shovle @ 6.50		26. 00		
1	hr. loader @ 4.00		4. 00		
			150. 00		
12/1/75	31' 6" Transite Pipe				
	10' 4" Cast Iron Pipe				

Deposit

DATE _____

TOWN OF LEXINGTON — BOARD OF PUBLIC WORKS
SEWER DIVISION

Sketch of Service Here **100**

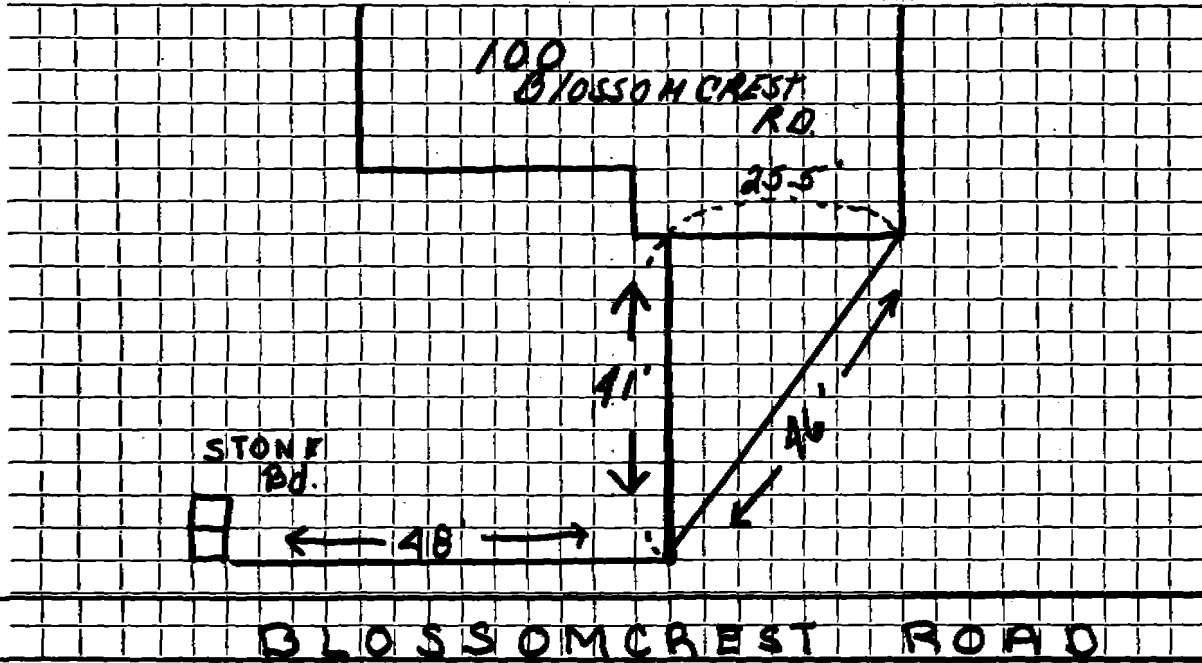

Connection made in Street. Work completed

Remarks:
.....
.....