

Name Busa Realty Trust

Service No. 15

Address 101 Blossomcrest Rd.

Location

Kind of Pipe

Size

Size of Main

~~Repair Work~~ - New Service W. O. # 8464

Dr. Elliott # 3034

Location JUN 5 1972


Date	Material	Amount	Total	Date	Amount
3/31/72	Labor	97 02		<i>5-2-72</i>	<i>Deposit</i> 500 00
4/14/72	"	24 83		<i>6-5-72</i>	<i>Paid by WHCA #7</i> 39 28
	10% O.H.	12 19	134 04	<i>5-13-72</i>	<i>Paid</i> 14 05
	20' 6" Transite pipe .90		18 00		<u>253 33</u>
	1 Cast Iron 6"x8" Saddle		15 95		
	1 6"x6" Nipple		1 28		
	1 30o El		4 89		
	1 6" Cap		2 55		
	2 Ton cold patch 8.00		16 00		
	2 1/2 " hot top 7.45		18 62		
	3 1/2 Hrs. Trucking 3.00		10 50		
	1.50		75		
	3 1/2 Hrs. Shovel 6.50		22 75		
	1 Hr. Compressor		5 00		
	1/2 Roller 2.00		1 00		
	Trailer		2 00		
4/15/72	28' 6" Transite pipe		253 33		
	10' 4" Cast Iron pipe				

DATE _____

TOWN OF LEXINGTON — BOARD OF PUBLIC WORKS
SEWER DIVISION

Sketch of Service Here

101

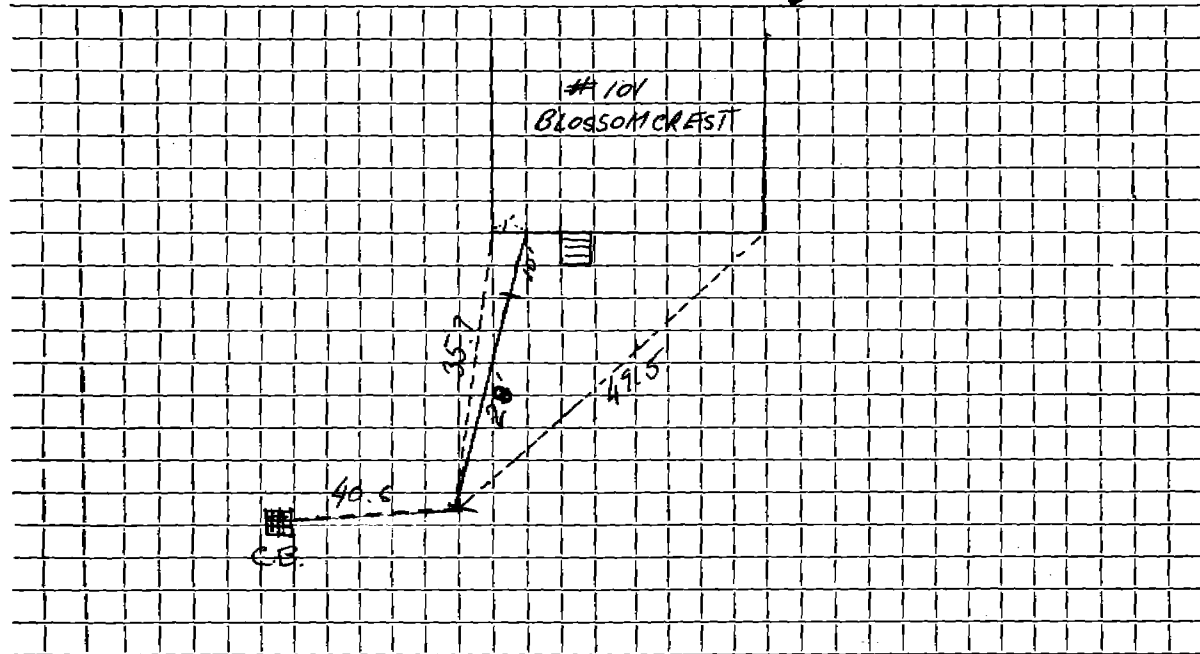

Connection made in Street. Work completed

Remarks:

.....

.....