

Name Theodore L. Freeman, jr. Huckleberry Lane, Acton

Service No. 151

Address 104 Blossomcrest Street

Location

Kind of Pipe Transite

Size 6"

Size of Main

~~Repair~~ New Service W.O. #3859 Arlex Permit #2787.

Location MAR 15 1976


Date	Material	Amount	Total	Date		Amount
12/18/75	Labor	\$122.25		12-4-75	Deposit	300.00
	10 % O.H.	12.23	\$134.48	3-15-76	Refund	38.25
20'	6" Transite Pipe	@1.48	29.60			261.28
1	6" Cap		3.75		NON-CHARGE	
1	6" x 8" CI Saddle		14.70	12/18/75	Labor	\$48.90
3½	Hrs. Trucking	@3.00	10.50			
1	Hr. Loader		4.00			
2½	Hrs. Town Shovel	@6.50	16.25			
1	Patch 18' x 4'		48.00			
			\$261.28			
3/25/76	91' 6" Transite Pipe					
	10' 4" Cast Iron Pipe					

DATE _____

TOWN OF LEXINGTON — BOARD OF PUBLIC WORKS
SEWER DIVISION

Sketch of Service Here

104

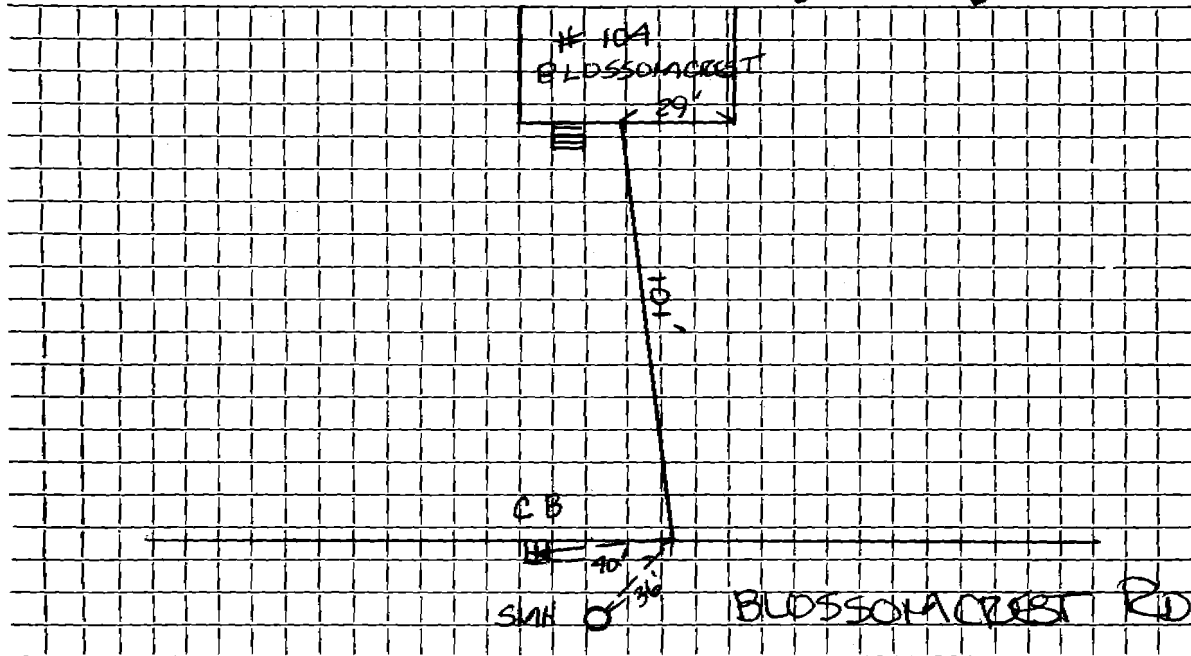

Connection made in BLOSSOMCREST RD. Street. Work completed 3-25-76

Remarks:

.....

.....